


1 LOCATION OF WATER WELL: County: Hamilton Fraction SE 1/4 SE 1/4 SW 1/4 Section Number 36 Township Number T 25 S Range Number R 42 EW

Distance and direction from nearest town or city street address of well if located within city? 10 mi South and 6 1/2 mi west of Syracuse, KS

2 WATER WELL OWNER: Bear Creek Feeders RR#, St. Address, Box #: HCO1 Box 62 City, State, ZIP Code: Syracuse, KS 67878 Board of Agriculture, Division of Water Resources Application Number:

3 LOCATE WELL'S LOCATION WITH AN "X" IN SECTION BOX:

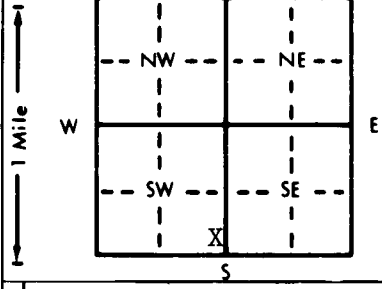

4 DEPTH OF COMPLETED WELL: 38.5 ft. ELEVATION: Depth(s) Groundwater Encountered 1. 37.65 ft. 2. ft. 3. ft.

WELL'S STATIC WATER LEVEL: 6/10/95 ft. below land surface measured on mo/day/yr Pump test data: Well water was ft. after hours pumping gpm Est. Yield gpm: Well water was ft. after hours pumping gpm Bore Hole Diameter: 2.08.5 in. to 38.5 ft., and in. to ft. WELL WATER TO BE USED AS: 5 Public water supply 8 Air conditioning 11 Injection well 1 Domestic 3 Feedlot 6 Oil field water supply 9 Dewatering 12 Other (Specify below) 2 Irrigation 4 Industrial 7 Lawn and garden only 10 Monitoring well MW-3 Was a chemical/bacteriological sample submitted to Department? Yes No; If yes, mo/day/yr sample was submitted Water Well Disinfected? Yes No

5 TYPE OF BLANK CASING USED: 1 Steel 3 RMP (SR) 5 Wrought iron 8 Concrete tile CASING JOINTS: Glued Clamped 2 PVC 4 ABS 6 Asbestos-Cement 9 Other (specify below) Welded Threaded Blank casing diameter 2.0 in. to 18.05 ft., Dia. in. to ft., Dia. in. to ft. Casing height above land surface 0.0 in., weight lbs./ft. Wall thickness or gauge No. Schd 40

TYPE OF SCREEN OR PERFORATION MATERIAL: 1 Steel 3 Stainless steel 5 Fiberglass 8 RMP (SR) 10 Asbestos-cement 2 Brass 4 Galvanized steel 6 Concrete tile 9 ABS 11 Other (specify) 12 None used (open hole)

SCREEN OR PERFORATION OPENINGS ARE: 1 Continuous slot 3 Mill slot 5 Gauzed wrapped 8 Saw cut 11 None (open hole) 2 Louvered shutter 4 Key punched 6 Wire wrapped 9 Drilled holes 7 Torch cut 10 Other (specify)

SCREEN-PERFORATED INTERVALS: From 38.05 ft. to 18.05 ft. GRAVEL PACK INTERVALS: From 38.5 ft. to 16.00 ft.

6 GROUT MATERIAL: 1 Neat cement 2 Cement grout 3 Bentonite 4 Other Grout Intervals: From 16.0 ft. to 3.0 ft., From 3.0 ft. to 0.0 ft.

What is the nearest source of possible contamination: 1 Septic tank 4 Lateral lines 7 Pit privy 10 Livestock pens 14 Abandoned water well 2 Sewer lines 5 Cess pool 8 Sewage lagoon 11 Fuel storage 15 Oil well/Gas well 3 Watertight sewer lines 6 Seepage pit 9 Feedyard 12 Fertilizer storage 16 Other (specify below) 13 Insecticide storage Direction from well? How many feet?

Table with columns: FROM, TO, LITHOLOGIC LOG, FROM, TO, PLUGGING INTERVALS. Content: 0 to 10 silty SAND, 10 to 15.9 silty CLAY, 15.9 to shale inter bedded with lenses of gypsum and clay. Includes signature: Flush mounts approved by Don Taylor, KDHE

7 CONTRACTOR'S OR LANDOWNER'S CERTIFICATION: This water well was (1) constructed, (2) reconstructed, or (3) plugged under my jurisdiction and was completed on (mo/day/year) 6/12/95 and this record is true to the best of my knowledge and belief. Kansas Water Well Contractor's License No. 540 This Water Well Record was completed on (mo/day/yr) 7/19/95 under the business name of Prairie Land Environmental Remediation by (signature)