


WATER WELL RECORD Form WWC-5 KSA 82a-1212

1 LOCATION OF WATER WELL: Fraction SE 1/4 SE 1/4 SW 1/4 Section Number 36 Township Number T 25 S Range Number R 42 EW County: Hamilton

Distance and direction from nearest town or city street address of well if located within city? 10 miles south and 6 1/2 miles west of Syracuse, KS

2 WATER WELL OWNER: Bear Creek Feeders RR#, St. Address, Box #: HC01, Box 62 City, State, ZIP Code: Syracuse, KS 67878 Board of Agriculture, Division of Water Resources Application Number:

3 LOCATE WELL'S LOCATION WITH AN "X" IN SECTION BOX:

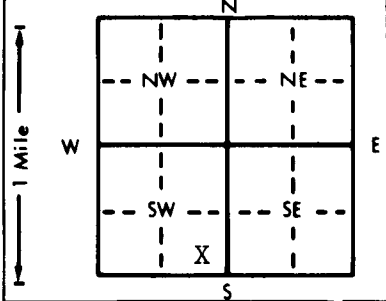

4 DEPTH OF COMPLETED WELL: 41 ft. ELEVATION: Depth(s) Groundwater Encountered 1. 37 ft. 2. ft. 3. ft. WELL'S STATIC WATER LEVEL: ft. below land surface measured on mo/day/yr Pump test data: Well water was ft. after hours pumping gpm Est. Yield gpm: Well water was ft. after hours pumping gpm Bore Hole Diameter: 8.5 in. to 41 ft., and in. to ft. WELL WATER TO BE USED AS: 5 Public water supply 8 Air conditioning 11 Injection well 1 Domestic 3 Feedlot 6 Oil field water supply 9 Dewatering 12 Other (Specify below) 2 Irrigation 4 Industrial 7 Lawn and garden only 10 Monitoring well MW6 Was a chemical/bacteriological sample submitted to Department? Yes.....No.....; If yes, mo/day/yr sample was submitted Water Well Disinfected? Yes No

5 TYPE OF BLANK CASING USED: 1 Steel 2 PVC 3 RMP (SR) 4 ABS 5 Wrought iron 6 Asbestos-Cement 7 Fiberglass 8 Concrete tile 9 Other (specify below) CASING JOINTS: Glued Clamped Welded Threaded X

Blank casing diameter: 2.0 in. to 18.15 ft., Dia. in. to ft., Dia. in. to ft. Casing height above land surface: 0.0 in., weight lbs./ft. Wall thickness or gauge No. Sched. 40

TYPE OF SCREEN OR PERFORATION MATERIAL: 1 Steel 2 Brass 3 Stainless steel 4 Galvanized steel 5 Fiberglass 6 Concrete tile 7 PVC 8 RMP (SR) 9 ABS 10 Asbestos-cement 11 Other (specify) 12 None used (open hole)

SCREEN OR PERFORATION OPENINGS ARE: 1 Continuous slot 2 Louvered shutter 3 Mill slot 4 Key punched 5 Gauzed wrapped 6 Wire wrapped 7 Torch cut 8 Saw cut 9 Drilled holes 10 Other (specify) 11 None (open hole)

SCREEN-PERFORATED INTERVALS: From 38.15 ft. to 18.15 ft., From ft. to ft. GRAVEL PACK INTERVALS: From 41.0 ft. to 16.00 ft., From ft. to ft.

6 GROUT MATERIAL: 1 Neat cement 2 Cement grout 3 Bentonite 4 Other Grout Intervals: From 16.0 ft. to 3.0 ft., From 3.0 ft. to 0.0 ft., From ft. to ft.

What is the nearest source of possible contamination: 1 Septic tank 2 Sewer lines 3 Watertight sewer lines 4 Lateral lines 5 Cess pool 6 Seepage pit 7 Pit privy 8 Sewage lagoon 9 Feedyard 10 Livestock pens 11 Fuel storage 12 Fertilizer storage 13 Insecticide storage 14 Abandoned water well 15 Oil well/Gas well 16 Other (specify below)

Direction from well? How many feet? LITHOLOGIC LOG FROM TO 0 1.2 silt sand and gravel 1.2 3.0 clayey silt trace sand 3.0 10.0 silty clay sand, trace gravel 10 18.0 shale 18.0 18.5 gray clay 18.5 brown and gray shale PLUGGING INTERVALS FROM TO

Flush mount approved by Don Taylor, KDHE

7 CONTRACTOR'S OR LANDOWNER'S CERTIFICATION: This water well was (1) constructed, (2) reconstructed, or (3) plugged under my jurisdiction and was completed on (mo/day/year) 6/13/95 and this record is true to the best of my knowledge and belief. Kansas Water Well Contractor's License No. 540 This Water Well Record was completed on (mo/day/yr) 7/19/95 under the business name of Prairie Land Environmental Remediation, Inc. by signature