


1 LOCATION OF WATER WELL: County: Hamilton Fraction: SE 1/4 SE 1/4 SW 1/4 Section Number: 36 Township Number: T 25 S Range Number: R 42 E(N)

Distance and direction from nearest town or city street address of well if located within city?  
10mi South and 6 1/2 mi West of Syracuse, KS

2 WATER WELL OWNER: Bear Creek Feeders  
 RR#, St. Address, Box #: HCO1 Box 62 Board of Agriculture, Division of Water Resources  
 City, State, ZIP Code: Syracuse, KS 67878 Application Number:

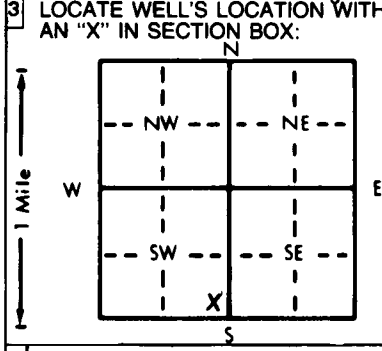

4 DEPTH OF COMPLETED WELL: 40 ft. ELEVATION:  
 Depth(s) Groundwater Encountered 1. 36.5 ft. 2. ft. 3. ft.  
 WELL'S STATIC WATER LEVEL 29.01 ft. below land surface measured on mo/day/yr 6.10.95  
 Pump test data: Well water was ft. after hours pumping gpm  
 Est. Yield gpm: Well water was ft. after hours pumping gpm  
 Bore Hole Diameter: 8.5 in. to 40 ft., and in. to ft.  
 WELL WATER TO BE USED AS:  
 Domestic  3 Feedlot  6 Oil field water supply  9 Dewatering  12 Other (Specify below)  
 2 Irrigation  4 Industrial  7 Lawn and garden only  10 Monitoring well SB-3 Explorative Bore  
 Was a chemical/bacteriological sample submitted to Department? Yes No ; If yes, mo/day/yr sample was submitted  
 Water Well Disinfected? Yes No

5 TYPE OF BLANK CASING USED:  
 1 Steel 3 RMP (SR) 5 Wrought iron 8 Concrete tile CASING JOINTS: Glued Clamped  
 2 PVC 6 Asbestos-Cement 9 Other (specify below) Welded  
 Blank casing diameter 8.75 in. to ft., Dia. in. to ft., Dia. in. to ft.  
 Casing height above land surface 0 in., weight lbs./ft. Wall thickness or gauge No.  
 TYPE OF SCREEN OR PERFORATION MATERIAL:  
 1 Steel 3 Stainless steel 5 Fiberglass 8 RMP (SR) 10 Asbestos-cement  
 2 Brass 4 Galvanized steel 6 Concrete tile 9 ABS 11 Other (specify) NA  
 12 None used (open hole)  
 SCREEN OR PERFORATION OPENINGS ARE:  
 1 Continuous slot 3 Mill slot 5 Gauzed wrapped 8 Saw cut 11 None (open hole)  
 2 Louvered shutter 4 Key punched 6 Wire wrapped 9 Drilled holes  
 7 Torch cut 10 Other (specify) NA  
 SCREEN-PERFORATED INTERVALS: From NA ft. to NA ft., From ft. to ft.  
 GRAVEL PACK INTERVALS: From ft. to ft., From ft. to ft.

6 GROUT MATERIAL: 1 Neat cement 2 Cement grout 3 Bentonite 4 Other  
 Grout Intervals: From 40 ft. to 3 ft., From ft. to ft., From ft. to ft.  
 What is the nearest source of possible contamination:  
 1 Septic tank 4 Lateral lines 7 Pit privy  10 Livestock pens 14 Abandoned water well  
 2 Sewer lines 5 Cess pool 8 Sewage lagoon 11 Fuel storage 15 Oil well/Gas well  
 3 Watertight sewer lines 6 Seepage pit 9 Feedyard 12 Fertilizer storage 16 Other (specify below)  
 13 Insecticide storage  
 Direction from well? West How many feet? 50ft

FROM	TO	LITHOLOGIC LOG	FROM	TO	PLUGGING INTERVALS
0	11.5	silty SAND	0	3	surface silts and clay
11.5	20.0	silty CLAY	3	40	Bentonite grout
20.0		shale interbedded with lenses of gypsum and clay			

7 CONTRACTOR'S OR LANDOWNER'S CERTIFICATION: This water well was 1 constructed, 2 reconstructed, or 3 plugged under my jurisdiction and was completed on (mo/day/year) 6/8/95 and this record is true to the best of my knowledge and belief. Kansas Water Well Contractor's License No. 540 This Water Well Record was completed on (mo/day/yr) 6/8/95 under the business name of Prairie Land Environmental Remediation by (signature) [Signature]

INSTRUCTIONS: Use typewriter or ball point pen. PLEASE PRESS FIRMLY and PRINT clearly. Please fill in blanks, underline or circle the correct answers. Send top three copies to Kansas Department of Health and Environment, Bureau of Water, Topeka, Kansas 66620-0001. Telephone: 913-296-5545. Send one to WATER WELL OWNER and retain one for your records.