

USE TYPEWRITER OR BALL
POINT PEN-PRESS FIRMLY,
PRINT CLEARLY.

T R EW sec 1/4 1/4 1/4 No.


WATER WELL RECORD
KSA 82a-1201-1215

Kansas State Dept. Of Health
(Water Well Contractors)
Forbes-Bldg. 740
Topeka, Kansas 66620

1 Location of well: County Hamilton Township name _____ Fraction NW $\frac{1}{4}$, NW $\frac{1}{4}$, SW $\frac{1}{4}$ Section number 34 Town number T 25 S Range number R 42 W

Distance and direction from nearest town or city:
10 S. 8 W. of Syracuse
Street address of well location if in city:

3 Owner of well: Dee Potter
Address: Syracuse, Kansas 67878

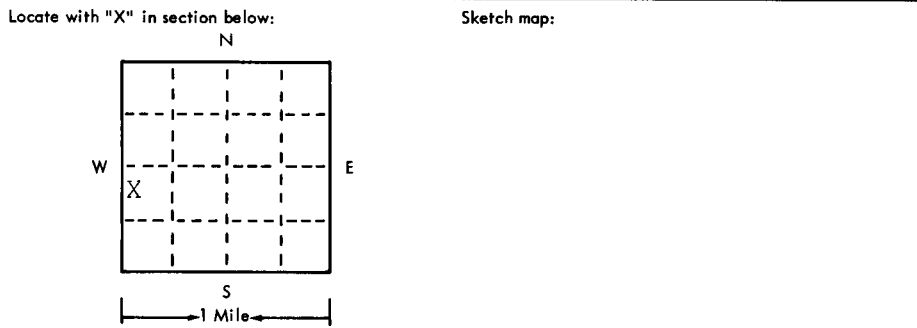

4 Well depth: 332 ft. Date of completion 3/15/75
Well diameter 26 in.

5 Cable tool Rotary Driven Dug
 Hollow rod Jetted Bored Reverse rotary

6 Use: Domestic Public supply Industry
 Irrigation Air conditioning Commercial
 Test well

7 Casing: Material Steel Height: above below
Threaded Welded Surface 12 in.
Diam. _____ Weight 36 lbs./ft.
16 in. to 332 ft. depth Drive shoe? Yes No
_____ in. to _____ ft. depth

2	Type and color of material	From	To
	<u>See attachment</u>		

(use a second sheet if needed)

8 Screen: Manufacturer Johnson
Type Continuous Dia. 16"
Slot/gauze 100 Length 30'
Set between 236 ft. and 246 ft.
Fittings: 276' & 296'
Gravel pack Yes No Size range of material 1/4" to 1/8"

9 Static water level: 175 ft. below land surface Date 2-17-75

10 Pumping level below land surfaces:
244 ft. after _____ hrs. pumping 905 g.p.m.
_____ ft. after _____ hrs. pumping _____ g.p.m.
Estimated maximum yield _____ g.p.m.

11 Water sample submitted:
 Yes No Date _____

12 Well head completion: 12
 Pitless adapter Inches above grade

13 Well grouted? Yes No
 Neat cement Bentonite _____
Depth: From 0 ft. to 10 ft.

14 Nearest source of possible contamination: None Observed
ft. _____ Direction _____ Type _____
Well disinfected upon completion? Yes No

15 Pump: Not installed
Manufacturer's name _____
Model number _____ HP _____ Volts _____
Length of drop pipe _____ ft. capacity _____ g.m.p.
Type:
 Submersible Turbine
 Jet Reciprocating
 Centrifugal Other

16 Remarks: elevation _____

Topography:
 Hill
 Slope
 Upland
 Valley

17 Water well contractor's certification:
This well was drilled under my jurisdiction and this report is true to the best of my knowledge and belief.
Henkle Drilling & Supply 145
Business name _____ Box 639 Garden City, KS license No. _____
Address _____
Signed Richard Henkle Date 4/8/75
Authorized representative

DRILLERS TEST LOG

CUSTOMERS NAME Dee Potter DATE 2-11-75
STREET ADDRESS _____ TEST # 7
CITY & STATE Syracuse, Kansas DRILLER Livingston
COUNTY Hamilton QUARTER SW SECTION 34 TOWNSHIP 25 RANGE 42

LOCATION 100 Ft. NW of well

WELL LOCATION

%	Drilled from	Pay	Footage to	Description of Strata	Static Water Level Proposed Well Depth
	0		2	Top soil	
	2		40	Brown clay and few fine sand st.	
	40		47	Sand fine to med. coarse	
	47		174	Brown clay and few sand st.	
	174		230	Weathered shale and limestone ledges, from 200' to 210'	
	230	100	330	Dakota and rock ledges. Lost circulation at 237'. Drills loose from 237 ft. Drills loose from 265' to 280' Few shale St.	
				Drilled blind	
	330		340	Shale	
				7 sacks of revert	
				6 sacks Quick Gel	
				4 sacks of bran	
				WELL DEPTH 332'	
				SET UP EAST WITH PIT ON THE SOUTH.	

GARDEN CITY, KANSAS
PHONE 276-3278
test holes
stock wells

HENKLE DRILLING & SUPPLY CO., INC.
IRRIGATION HEADQUARTERS

CONCRETE WORKS
PHONE 673-4513
IRRIGATION
INDUSTRY