


1 LOCATION OF WATER WELL:
County: Hamilton
Fraction: SW 1/4 SW 1/4 SE 1/4
Section Number: 36
Township Number: T 25 S
Range Number: R 42
Distance and direction from nearest town or city street address of well if located within city?
HC01, Box 62 - Syracuse

2 WATER WELL OWNER: Kansas Department of Health and Environment
RR#, St. Address, Box #: 1000 SW Jackson St., Ste. 410
City, State, ZIP Code: Topeka, KS 66612
Board of Agriculture, Division of Water Resources
Application Number:

3 LOCATE WELL'S LOCATION WITH AN 'X' IN SECTION BOX:

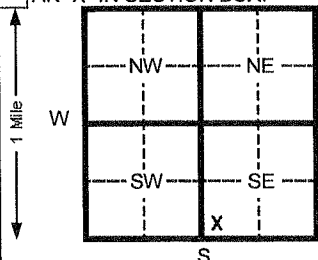

4 DEPTH OF COMPLETED WELL: 43.7 ft. ELEVATION: 3434.61 (TOC)

Depth(s) Groundwater Encountered: 1 ft. 2 ft. 3 ft.
WELL'S STATIC WATER LEVEL: 26.98 ft. below TOC measured on mo/day/yr 04/23/14

Pump test data: Well water was ___ ft. after ___ hours pumping ___ gpm
Est. Yield ___ gpm: Well water was ___ ft. after ___ hours pumping ___ gpm

Bore Hole Diameter: 8.25 in. to 45 in.
WELL WATER TO BE USED AS: 5 Public water supply 8 Air conditioning 11 Injection well
1 Domestic 3 Feed lot 6 Oil field water supply 9 Dewatering 12 Other (Specify below)

2 Irrigation 4 Industrial 7 Lawn and garden (domestic) 10 Monitoring well

Was a chemical/bacteriological sample submitted to Department? Yes ___ No X
Water Well Disinfected? Yes ___ No X

5 TYPE OF BLANK CASING USED:
1 Steel 3 RMP (SR) 5 Wrought Iron 8 Concrete tile CASING JOINTS: Glued Clamped
2 PVC 4 ABS 6 Asbestos-Cement 9 Other (specify below) Welded

Blank casing diameter: 2 in. to 23.7 ft. Dia
Casing height above land surface: 0 in., weight: 0.703 lbs./ft. Wall thickness or gauge No. SCH. 40

TYPE OF SCREEN OR PERFORATION MATERIAL:
1 Steel 3 Stainless steel 5 Fiberglass 8 RMP (SR) 11 Other (specify)
2 Brass 4 Galvanized steel 6 Concrete tile 9 ABS 12 None used (open hole)

SCREEN OR PERFORATION OPENINGS ARE:
1 Continuous slot 3 Mill slot 5 Gauzed wrapped 8 Saw cut 11 None (open hole)
2 Louvered shutter 4 Key punched 7 Torch cut 10 Other (specify)

SCREEN-PERFORATED INTERVALS: From 23.7 ft. to 43.7 ft.

GRAVEL PACK INTERVALS: From 21 ft. to 45 ft.

6 GROUT MATERIAL: 1 Neat cement 2 Cement grout 3 Bentonite 4 Other

Grout Intervals From 1 ft. to 21 ft. From ___ ft. to ___ ft.

What is the nearest source of possible contamination:
1 Septic tank 4 Lateral lines 7 Pit privy 10 Livestock pens 14 Abandoned water well
2 Sewer lines 5 Cess pool 8 Sewage lagoon 11 Fuel storage 15 Oil well/ Gas well
3 Watertight sewer lines 6 Seepage pit 9 Feedyard 12 Fertilizer storage 16 Other (specify below)

Direction from well? How many feet?

Table with columns: FROM, TO, CODE, LITHOLOGIC LOG, FROM, TO, PLUGGING INTERVALS. Contains descriptions like Topsoil/Gravel, Silty Clay, tan, Silty Clay to Silt, brown, Clay, tan, very little silt, with thin caliche, Silty Clay, brown, some caliche, some sand.

7 CONTRACTOR'S OR LANDOWNER'S CERTIFICATION: This water well was (1) constructed, (2) reconstructed, or (3) plugged under my jurisdiction and was completed on (mo/day/yr) 04/22/14 and this record is true to the best of my knowledge and belief. Kansas Water Well Contractor's License No. 531 This Water Well Record was completed on (mo/day/yr) 05/12/14 under the business name of GSI Engineering, LLC by (signature)

INSTRUCTIONS: Please fill in blanks and circle the correct answers. Send three copies to Kansas Department of Health and Environment, Bureau of Water, 1000 S W Jackson St., Ste. 420, Topeka, Kansas 66612-1367. Telephone: 913-296-5545. Send one to WATER WELL OWNER and retain one for your records.

OFFICE USE ONLY

T R

SEC