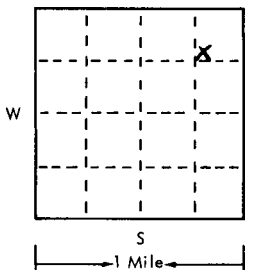
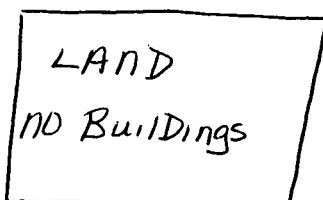


USE TYPEWRITER OR BALL POINT PEN-PRESS FIRMLY, PRINT CLEARLY.

T R EW sec 1/4 1/4 1/4 No.

WATER WELL RECORD
KSA 82a-1201-1215

Kansas State Dept. Of Health
(Water Well Contractors)
Forbes-Bldg. 740
Topeka, Kansas 66620

1 Location of well:	County: HAMILTON	Township name: BEAR CREEK	Fraction: SW 1/4 NE 1/4	Section number: 21	Town number: 25E	Range number: 43W		
Distance and direction from nearest town or city: 8 miles south of Coolidge, Kansas			3 Owner of well: GARRETT-JONES FARMS Address: 1011 N 79TH ST. LINCOLN, NEBRASKA 68501					
Locate with "X" in section below: N  W E S 1 Mile			Sketch map: 			4 Well depth: 420 ft. Date of completion: 4-17-76 Well diameter: 27 in.		
2 Type and color of material			From		To			
			Top Soil		0		5	
			CLAY		5		40	
			CLAY SANDY		40		55	
			CLAY		55		85	
			SAND		85		200	
			SAND CLAY		200		225	
			SHALE		225		270	
			SAND SHALE		270		295	
			SAND		295		320	
SANDSTONE BROWN SHALE		320		330				
SAND		330		420				
(use a second sheet if needed)								
16 Remarks: elevation 3230 Topography: <input type="checkbox"/> Hill <input checked="" type="checkbox"/> Slope <input type="checkbox"/> Upland <input type="checkbox"/> Valley LAND SLOPES TO NORTH			4 Well depth: 420 ft. Date of completion: 4-17-76 Well diameter: 27 in.					
			5 <input type="checkbox"/> Cable tool <input checked="" type="checkbox"/> Rotary <input type="checkbox"/> Driven <input type="checkbox"/> Dug <input type="checkbox"/> Hollow rod <input type="checkbox"/> Jetted <input type="checkbox"/> Bored <input type="checkbox"/> Reverse rotary					
			6 Use: <input type="checkbox"/> Domestic <input type="checkbox"/> Public supply <input type="checkbox"/> Industry <input checked="" type="checkbox"/> Irrigation <input type="checkbox"/> Air conditioning <input type="checkbox"/> Commercial <input type="checkbox"/> Test well					
			7 Casing: Material STEEL Height: above /below Threaded <input type="checkbox"/> Welded <input checked="" type="checkbox"/> Surface 24 in. Diam. 16 in. to 40 ft. depth! Drive shoe? <input type="checkbox"/> Yes <input checked="" type="checkbox"/> No 16 in. to 40 ft. depth!					
			8 Screen: Manufacturer ARMCO STEEL Type STEEL 5/16 W Dia. 16" 5/16 gauze 3/16" Length 220' Set between 200 ft. and 420 ft. Fittings: Gravel pack <input checked="" type="checkbox"/> Yes <input type="checkbox"/> No Size range of material 1/4					
			9 Static water level: 160 ft. below land surface Date 6-5-76					
			10 Pumping level below land surfaces: 200 ft. after 6 hrs. pumping 800 g.p.m. 260 ft. after 20 hrs. pumping 1000 g.p.m. Estimated maximum yield 1200 g.p.m.					
			11 Water sample submitted: <input type="checkbox"/> Yes <input checked="" type="checkbox"/> No Date _____					
			12 Well head completion: <input type="checkbox"/> Pitless adapter 20 inches above grade					
			13 Well grouted? <input checked="" type="checkbox"/> Yes <input type="checkbox"/> No <input checked="" type="checkbox"/> Neat cement <input checked="" type="checkbox"/> Bentonite <input type="checkbox"/> _____ Depth: From 0 ft. to 20 ft.					
			14 Nearest source of possible contamination: ft. 1320 Direction SW Type RO Well disinfected upon completion? <input type="checkbox"/> Yes <input checked="" type="checkbox"/> No					
			15 Pump: <input type="checkbox"/> Not installed Manufacturer's name A-C TAIT Model number _____ HP 120 Volts _____ Length of drop pipe 320 ft. capacity 1200 g.m.p. Type: <input type="checkbox"/> Submersible <input checked="" type="checkbox"/> Turbine <input type="checkbox"/> Jet <input type="checkbox"/> Reciprocating <input type="checkbox"/> Centrifugal <input type="checkbox"/> Other					
17 Water well contractor's certification: This well was drilled under my jurisdiction and this report is true to the best of my knowledge and belief. DREILING, Inc. License No. 210 Business name _____ Address Box 457 Holly, Colo 81047 Signed D. Dreiling Date 1-10-76 Authorized representative								

25 43W 21 SW NE NE