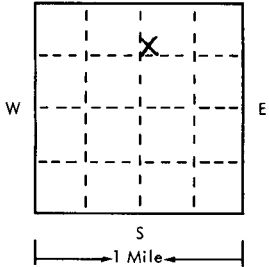
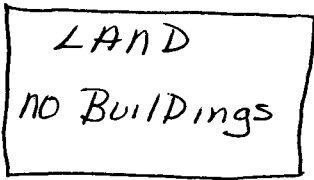


USE TYPEWRITER OR BALL
POINT PEN-PRESS FIRMLY
PRINT CLEARLY.

WATER WELL RECORD
KSA 82a-1201-1215

T R EW sec 1/4 1/4 1/4 No.

Kansas State Dept. Of Health
(Water Well Contractors)
Forbes-Bldg. 740
Topeka, Kansas 66620

1 Location of well:	County: <u>HAMILTON</u>	Township name: <u>BEAR CREEK</u>	Fraction: <u>NW NE SW SE NW</u>	Section number: <u>26</u>	Town number: <u>255</u>	Range number: <u>43W</u>
Distance and direction from nearest town or city: <u>8 miles south of</u>				3 Owner of well: <u>GARRETT-JONES FARMS</u>		
Street address of well location if in city: <u>COOLIDGE, KANSAS</u>				Address: <u>1011 N 79TH ST. LINCOLN, NEBRASKA 68501</u>		
Locate with "X" in section below:		Sketch map:		4 Well depth: <u>438</u> ft. Date of completion: <u>4-25-75</u>		
				Well diameter: <u>27</u> in.		
2		Type and color of material		From		To
		<u>TOP SOIL</u>		<u>0</u>		<u>5</u>
		<u>CLAY</u>		<u>5</u>		<u>100</u>
		<u>CLAY SANDY</u>		<u>100</u>		<u>120</u>
		<u>CLAY</u>		<u>120</u>		<u>135</u>
		<u>SAND</u>		<u>135</u>		<u>140</u>
		<u>SAND CLAY</u>		<u>140</u>		<u>145</u>
		<u>SAND</u>		<u>145</u>		<u>150</u>
		<u>SAND CLAY</u>		<u>150</u>		<u>160</u>
		<u>SAND</u>		<u>160</u>		<u>165</u>
		<u>SAND CLAY</u>		<u>165</u>		<u>170</u>
		<u>SAND</u>		<u>170</u>		<u>195</u>
		<u>SAND SHALE STRK.</u>		<u>195</u>		<u>220</u>
		<u>SAND</u>		<u>220</u>		<u>315</u>
		<u>DAKOTA SAND</u>		<u>315</u>		<u>440</u>
		(use a second sheet if needed)				
16 Remarks: elevation <u>3235</u>				17 Water well contractor's certification:		
Topography: <u>LAND SLOPES TO NE</u>				This well was drilled under my jurisdiction and this report is true to the best of my knowledge and belief.		
☐ Hill				Business name: <u>Dee-Ling, Inc</u> License No. <u>210</u>		
☒ Slope				Address: <u>Box 457 Holly, Co Mo 64047</u>		
☐ Upland				Signed: <u>[Signature]</u> Date: <u>1-10-76</u>		
☐ Valley				Authorized representative		