

County: Reno Fraction: SE SE SW Sec. 4 T 25 S R 6 W

CORRECTION(S) TO WATER WELL COMPLETION RECORD (WWC-5) - to rectify lacking or incorrect information

Owner: James P. Doyle

If corrected, location was listed as:

Location changed to:

Section-Township-Range: _____

Fraction ($\frac{1}{4}$ $\frac{1}{4}$ $\frac{1}{4}$): _____

Other changes: Initial statements: Owner listed (Cecil Keeler) is the original
owner of the home.

Changed to: Current owner is James P. Doyle.

Comments: _____

Verification method: Email notification from owner.

Initials: DAH Date: Feb. 13, 2019


Submitted by: ☒ Kansas Geological Survey, Data Resources Library, 1930 Constant Avenue, Lawrence, KS 66047-3724
☐ Kansas Dept. of Health & Environment, Bureau of Water, 1000 SW Jackson, Suite 420, Topeka, KS 66612-1367

1 LOCATION OF WATER WELL:		Fraction	Section Number	Township Number	Range Number
County:	Reno	SE 1/4 SE 1/4 SW 1/4	4	T 25 S	R 6 E/W

Distance and direction from nearest town or city street address of well if located within city?
2 mi N, 1/2 W of Castleton - 3704 W Arlington Rd

2	WATER WELL OWNER:	Cecil Keeler	
	RR#, St. Address, Box # :	3704 W Arlington Rd	Board of Agriculture, Division of Water Resources
	City, State, ZIP Code :	Hutch, KS 67501	Application Number:

3 LOCATE WELL'S LOCATION WITH AN "X" IN SECTION BOX: 4 DEPTH OF COMPLETED WELL... 62 ... ft. ELEVATION:

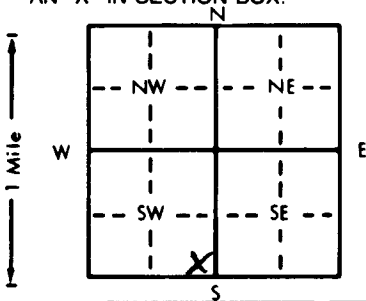

4 DEPTH OF COMPLETED WELL... 62 ft. ELEVATION: _____

Depth(s) Groundwater Encountered 1. _____ ft. 2. _____ ft. 3. _____ ft.

WELL'S STATIC WATER LEVEL... 2.6 ft. below land surface measured on mo/day/yr 4-28-99

Pump test data: Well water was 3.2 ft. after 1/2 hours pumping 25 gpm

Est. Yield _____ gpm: Well water was _____ ft. after _____ hours pumping _____ gpm

Bore Hole Diameter... 9 in. to 64 ft., and _____ in. to _____ ft.

WELL WATER TO BE USED AS:

5 Public water supply	8 Air conditioning	11 Injection well		
1 Domestic	3 Feedlot	6 Oil field water supply	9 Dewatering	12 Other (Specify below)
2 Irrigation	4 Industrial	7 Lawn and garden only	10 Monitoring well	<u>5. OTHER</u>

Was a chemical/bacteriological sample submitted to Department? Yes _____ No X; If yes, mo/day/yr sample was submitted _____

Water Well Disinfected? Yes X No _____

5	TYPE OF BLANK CASING USED:		5 Wrought iron	8 Concrete tile	CASING JOINTS: Glued ☒ . . . Clamped
	1 Steel	3 RMP (SR)	6 Asbestos-Cement	9 Other (specify below)	Welded
	2 PVC	4 ABS	7 Fiberglass		Threaded

Blank casing diameter 6 in. to 32 ft. Dia. in. to ft. Dia. in. to ft.
Casing height above land surface 12 in. weight lbs./ft. Wall thickness or gauge No. 160

TYPE OF SCREEN OR PERFORATION MATERIAL:

1 Steel	3 Stainless steel	5 Fiberglass	7 PVC	10 Asbestos-cement
2 Brass	4 Galvanized steel	6 Concrete tile	8 RMP (SR)	11 Other (specify)
			9 ABS	12 None used (open hole)

SCREEN OR PERFORATION OPENINGS ARE:

1 Continuous slot	3 Mill slot	5 Gauzed wrapped	8 Saw cut	11 None (open hole)
2 Louvered shutter	4 Key punched	6 Wire wrapped	9 Drilled holes	
		7 Torch cut	10 Other (specify)	

SCREEN-PERFORATED INTERVALS:	From 52	ft. to 62	ft., From	ft. to	ft.
	From	ft. to	ft., From	ft. to	ft.
GRAVEL PACK INTERVALS:	From 23	ft. to 64	ft., From	ft. to	ft.
	From	ft. to	ft., From	ft. to	ft.

6 GROUT MATERIAL: 1 Neat cement 2 Cement grout 3 Bentonite 4 Other
Grout Intervals: From 3 ft. to 23 ft., From ft. to ft., From ft. to ft.

What is the nearest source of possible contamination:

1 Septic tank	4 Lateral lines	7 Pit privy	10 Livestock pens	14 Abandoned water well
2 Sewer lines	5 Cess pool	8 Sewage lagoon	11 Fuel storage	15 Oil well/Gas well
3 Watertight sewer lines	6 Seepage pit	9 Feedyard	12 Fertilizer storage	16 Other (specify below)

Direction from well? *NW*

How many feet? *300*

pond

[illegible]

7 CONTRACTOR'S OR LANDOWNER'S CERTIFICATION: This water well was (1) constructed, (2) reconstructed, or (3) plugged under my jurisdiction and was completed on (mo/day/year) 4-28-99 and this record is true to the best of my knowledge and belief. Kansas Water Well Contractor's License No. 447 This Water Well Record was completed on (mo/day/yr) 5-7-99 under the business name of Miller Drilling by (signature) E. Miller