

WATER WELL RECORD

Form WWC-5


Division of Water Resources App. No.

Blank box for application number

1 LOCATION OF WATER WELL: County: Reno, Fraction: NE 1/4 NE 1/4 NW 1/4 SW 1/4, Section Number: 33, Township No.: T 25 S, Range Number: R 6, E/W checkboxes

Street/Rural Address of Well Location; if unknown, distance & direction from nearest town or intersection: From Hwy. 14 & Parallel Rd. 2 3/4 W NSR. Global Positioning System (GPS) information: Latitude: 37.83116, Longitude: 097.99092, Elevation: 1562, Datum: WGS 84, NAD 83, NAD 27, Collection Method: GPS unit, Digital Map/Photo, Topographic Map, Land Survey, Est. Accuracy: <3 m, 3-5 m, 5-15 m, >15 m

2 WATER WELL OWNER: Richard Rogers, RR#, Street Address, Box #: 301 South Adams, City, State, ZIP Code: Pretty Prairie, Kansas 67570

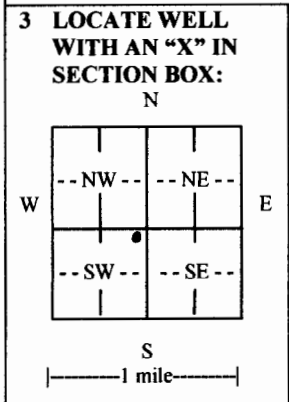

3 LOCATE WELL WITH AN "X" IN SECTION BOX: N, W, E, S. 4 DEPTH OF COMPLETED WELL 96 ft. Depth(s) Groundwater Encountered (1)..... ft. (2)..... ft. (3)..... ft. WELL'S STATIC WATER LEVEL 27 ft. below land surface measured on mo/day/yr. 7-29-2015. Pump test data: Well water was.....ft. after..... hours pumping..... gpm EST. YIELD.....gpm. Well water was.....ft. after..... hours pumping..... gpm Bore Hole Diameter 9 7/8 in. to 102 ft., andin. toft. WELL WATER TO BE USED AS: Public water supply, Geothermal, Injection well, Domestic, Feedlot, Oil field water supply, Dewatering, Other (Specify below), Irrigation, Industrial, Domestic-lawn & garden, Monitoring well, stock. Was a chemical/bacteriological sample submitted to Department? Yes No. If yes, mo/day/yr sample was submitted..... Water well disinfected? Yes No

5 TYPE OF CASING USED: Steel, PVC, Other. CASING JOINTS: Glued, Clamped, Welded, Threaded. Casing diameter 5 in. to 0.16 ft., Diameter 5 in. to 36-56 ft., Diameter in. to ft. Casing height above land surface 24 in., Weight 160 lbs./ft., Wall thickness or gauge No. 214. TYPE OF SCREEN OR PERFORATION MATERIAL: Steel, Stainless Steel, PVC, Other (Specify), Brass, Galvanized Steel, None used (open hole). SCREEN OR PERFORATION OPENINGS ARE: Continuous slot, Mill slot, Gauze wrapped, Torch cut, Drilled holes, None (open hole), Louvered shutter, Key punched, Wire wrapped, Saw cut, Other (specify). SCREEN-PERFORATED INTERVALS: From 16 ft. to 36 ft., From 56 ft. to 96 ft. GRAVEL PACK INTERVALS: From 96 ft. to 20 ft., From ft. to ft.

6 GROUT MATERIAL: Neat cement, Cement grout, Bentonite, Other. Grout Intervals: From 20 ft. to 0 ft., From ft. to ft. What is the nearest source of possible contamination: Septic tank, Lateral lines, Pit privy, Livestock pens, Insecticide storage, Other (specify below), Sewer lines, Cesspool, Sewage lagoon, Fuel storage, Abandoned water well, Watertight sewer lines, Seepage pit, Feedyard, Fertilizer storage, Oil well/gas well, creek. Direction from well West, Distance from well 200'

Table with columns: FROM, TO, LITHOLOGIC LOG, FROM, TO, LITHO. LOG (cont.) or PLUGGING INTERVALS. Rows include: 0-3 Top soil, 3-7 Brown clay, 7-24 Med-coarse sand and gravel, 24-31 Red shale brittle, 31-42 Green and red shale brittle, 42-50 Red shale w/pcs. of green-brittle, 50-60 Green shale w/pcs. of red shale, 60-72 Red shale w/pcs. of brittle shale, 72-80 Red shale w/pcs. of gypsum and brittle shale, 80-92 Green shale w/pcs. of gypsum and brittle shale, 92-96 Red shale w/pcs. of gypsum and brittle shale, 96-102 Green and red shale w/pcs. of avopsum and brittle shale.

7 CONTRACTOR'S OR LANDOWNER'S CERTIFICATION: This water well was constructed, reconstructed, or plugged under my jurisdiction and was completed on (mo/day/year) 7-29-2015 and this record is true to the best of my knowledge and belief. Kansas Water Well Contractor's License No. 134. This Water Well Record was completed on (mo/day/year) 8-6-2015 under the business name of Rosencrantz Bemis Ent. by (signature) Jesse DeLeon

INSTRUCTIONS: Use typewriter or ball point pen. PLEASE PRESS FIRMLY and PRINT clearly. Please fill in blanks and check the correct answers. Send three copies (white, blue, pink) to Kansas Department of Health and Environment, Bureau of Water, Geology Section, 1000 SW Jackson St., Suite 420, Topeka, Kansas 66612-1367. Telephone 785-296-5524. Send one copy to WATER WELL OWNER and retain one for your records. Include fee of \$5.00 for each constructed well. Visit us at http://www.kdheks.gov/waterwell/index.html.