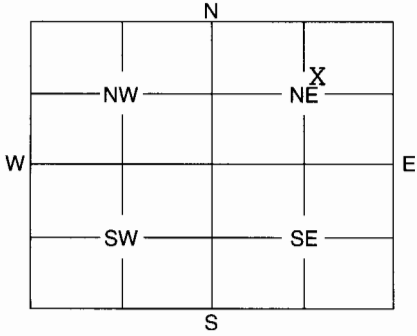


1	LOCATION OF WATER WELL:	Fraction	Section	Number	Township	Number	Range	Number
	County: Reno	NE 1/4 NE 1/4 SW 1/4	3		25	S	8	EW

Distance and direction from nearest town or city street address of well if located within city?

1.5 Miles North on HWY 14 off of HWY 61

2	WATER WELL OWNER: Ryan and Amie Mass 11919 N. HWY 14, South Sego Road RR #, St. Address, Box #: Arlington, KS 67514 City, State, ZIP Code	Board of Agriculture, Division of Water Resources Application Number:
---	---	--

3	MARK WELL'S LOCATION WITH AN "X" IN SECTION BOX: 	4	DEPTH OF WELL 71.5 ft. WELL'S STATIC WATER LEVEL 28.4 ft. WELL WAS USED AS: ☒ 1 Domestic ☐ 2 Irrigation ☐ 3 Feedlot ☐ 4 Industrial ☐ 5 Public Water Supply ☐ 6 Oil Field Water Supply ☐ 7 Domestic (Lawn & Garden) ☐ 8 Air Conditioning ☐ 9 Dewatering ☐ 10 Monitoring Well ☐ 11 Injection Well ☐ 12 Other Was a chemical / bacteriological sample submitted to Department? Yes No ☒ If yes, mo/day/yr sample was submitted Water Well Disinfected: Yes ☒ No
---	--	---	--

5	TYPE OF BLANK CASING USED: ☒ 1 Steel ☐ 2 PVC ☐ 3 RMP (SR) ☐ 4 ABS ☐ 5 Wrought ☐ 6 Asbestos-Cement ☐ 7 Fiberglass ☐ 8 Concrete Tile ☐ 9 Other (Specify below) Blank casing diameter 5 in. Was casing pulled? Yes No ☒ If yes, how much Casing height above <u>below</u> land surface 36 in.
---	---

6	GROUT PLUG MATERIAL: ☐ 1 Neat cement ☐ 2 Cement grout ☒ 3 Bentonite ☐ 4 Other Grout Plug Intervals: From 71.5 ft. to 3 ft., From ft. to ft., From to ft. What is the nearest source of possible contamination: ☐ 1 Septic tank ☐ 6 Seepage pit ☐ 11 Fuel storage ☐ 16 Other (specify below) ☐ 2 Sewer lines ☐ 7 Pit privy ☐ 12 Fertilizer storage ☐ 3 Watertight sewer lines ☐ 8 Sewage lagoon ☐ 13 Insecticide storage ☒ 4 Lateral lines ☐ 9 Feedyard ☐ 14 Abandoned water well ☐ 5 Cess pool ☐ 10 Livestock pens ☐ 15 Oil well/Gas well Direction from well? East How many feet? 100
---	--

FROM	TO	PLUGGING MATERIALS
71.5	3.0	3/8 Bentonite Chips

7	CONTRACTOR'S OF LANDOWNER'S CERTIFICATION: This water well was plugged under my jurisdiction and was completed on (mo/day/year) 11-03-05 and this record is true to the best of my knowledge and belief. Kansas Water Well Contractor's License No. 665 This Water Well Record was completed on (mo/day/year) 11-10-05 under the business name of Pratt Well Environmental by (signature) <i>Steven Gill</i>
---	---

INSTRUCTIONS: Use typewriter or ball point pen. Please press firmly and print clearly. Please fill in blanks, underline or circle the correct answers. Send top three copies to Kansas Department of Health and Environment, Bureau of Water, Geology Section, 1000 SW Jackson St., Ste. 420, Topeka, Kansas 66612-1367. Telephone: 785/296-5522. Send one to Water Well Owner and retain one for your records.