

LOCATION OF WATER WELL	Fraction	Section Number	Township Number	Range Number
County: <u>Rego</u>	<u>SE 1/4 SE 1/4 NE 1/4</u>	<u>1</u>	<u>T 25 S</u>	<u>R 9</u>
Distance and direction from nearest town or city? <u>3 mi W, 1 mi N of Arlington</u>		Street address of well if located within city? <u>NA</u>		

WATER WELL OWNER:
RR#, St. Address, Box # GWMD #5 / KGS
City, State, ZIP Code _____
Board of Agriculture, Division of Water Resources
Application Number: _____

DEPTH OF COMPLETED WELL 130 ft. Bore Hole Diameter 9 7/8 in. to _____ ft., and _____ in. to _____ ft.
Well Water to be used as:
1 Domestic 3 Feedlot 5 Public water supply 8 Air conditioning 11 Injection well
2 Irrigation 4 Industrial 6 Oil field water supply 9 Dewatering 12 Other (Specify below)
7 Lawn and garden only 10 Observation well Research
Well's static water level 25.7 ft. below land surface measured on Jan month 28 day 1983 year
Pump Test Data NA Well water was _____ ft. after _____ hours pumping. _____ gpm
Est. Yield _____ gpm Well water was _____ ft. after _____ hours pumping. _____ gpm

TYPE OF BLANK CASING USED:
1 Steel 3 RMP (SR) 5 Wrought iron 8 Concrete tile Casing Joints: Glued Clamped _____
2 PVC 4 ABS 6 Asbestos-Cement 9 Other (specify below) Welded _____
7 Fiberglass Threaded _____
Blank casing dia 5.0 in. to 12.5 ft. Dia _____ in. to _____ ft. Dia _____ in. to _____ ft.

Casing height above land surface _____ in. weight _____ lbs./ft. Wall thickness or gauge No Schd #40
TYPE OF SCREEN OR PERFORATION MATERIAL:
1 Steel 3 Stainless steel 5 Fiberglass 7 PVC 10 Asbestos-cement
2 Brass 4 Galvanized steel 6 Concrete tile 8 RMP (SR) 11 Other (specify) _____
9 ABS 12 None used (open hole)


Screen or Perforation Openings Are:
1 Continuous slot 3 Mill slot 5 Gauzed wrapped 8 Saw cut 11 None (open hole)
2 Louvered shutter 4 Key punched 6 Wire wrapped 9 Drilled holes
7 Torch cut 10 Other (specify) _____
Screen-Perforation Dia 5.0 in. to _____ ft. Dia _____ in. to _____ ft. Dia _____ in. to _____ ft.
Screen-Perforated Intervals: From 12.5 ft. to 130 ft. From _____ ft. to _____ ft. From _____ ft. to _____ ft.
Gravel Pack Intervals: From 12.3 ft. to 130 ft. From _____ ft. to _____ ft. From _____ ft. to _____ ft.

GROUT MATERIAL: 1 Neat cement 2 Cement grout 3 Bentonite 4 Other _____
Grouted Intervals: From 7.3 ft. to 12.3 ft. From 0 ft. to 10 ft. From _____ ft. to _____ ft.

What is the nearest source of possible contamination: None known
1 Septic tank 4 Cess pool 7 Sewage lagoon 10 Fuel storage 14 Abandoned water well
2 Sewer lines 5 Seepage pit 8 Feed yard 11 Fertilizer storage 15 Oil well/Gas well
3 Lateral lines 6 Pit privy 9 Livestock pens 12 Insecticide storage 16 Other (specify below)
13 Watertight sewer lines

Direction from well _____ How many feet _____ ? Water Well Disinfected? Yes _____ No _____
Was a chemical/bacteriological sample submitted to Department? Yes _____ No _____ If yes, date sample
was submitted _____ month _____ day _____ year: Pump Installed? Yes _____ No _____
If Yes: Pump Manufacturer's name _____ Model No. _____ HP _____ Volts _____
Depth of Pump Intake _____ ft. Pumps Capacity rated at _____ gal./min.
Type of pump: 1 Submersible 2 Turbine 3 Jet 4 Centrifugal 5 Reciprocating 6 Other _____

CONTRACTOR'S OR LANDOWNER'S CERTIFICATION: This water well was (1) constructed (2) reconstructed, or (3) plugged under my jurisdiction and was
completed on September month 9 day 1981 year.
and this record is true to the best of my knowledge and belief, Kansas Water Well Contractor's License No. _____
This Water Well Record was completed on _____ month _____ day _____ year under the business
name of _____ by (signature) _____

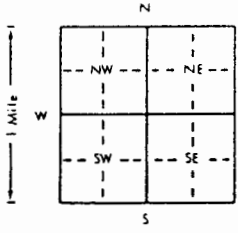LOCATE WELL'S LOCATION WITH AN "X" IN SECTION BOX:	FROM	TO	LITHOLOGIC LOG	FROM	TO	LITHOLOGIC LOG
	0	2	top soil, brown silty clay			
	2	10	orange clay, sandy			
	10	12	gravel, fine and med. grain			
	12	18	brown clay, sand and gravel streaks			
	18	117	sand and gravel, clay lenses caliche zones			
	117	140	red siltstone, streaks of gray			
ELEVATION: <u>1667.3</u>						

Depth(s) Groundwater Encountered 1. _____ ft. 2. _____ ft. 3. _____ ft. 4. _____ ft. (Use a second sheet if needed)
INSTRUCTIONS: Use typewriter or ball point pen, please press firmly and PRINT clearly. Please fill in blanks, underline or circle the correct answers. Send top three copies to Kansas Department of Health and Environment, Division of Environment, Water Well Contractors, Topeka, KS 66620. Send one to WATER WELL OWNER and retain one for your records.

BIG BEND GMD#5-KGS
WATER QUALITY
OBSERVATION WELL
NETWORK

SITE NUMBER : 28
SITE LOCATION: SE SE NE


LEGAL LOCATION: 1-25-9W
COUNTY : RENO

WELL LOG

[illegible]

SITE NUMBER : 28
SITE LOCATION : SE SE NE
LEGAL LOCATION: SEC1 T25S R9W
COUNTY : RENO

LANDOWNER: CARL H. BREIDENSTEIN
ADDRESS : RURAL ROUTE 1
ARLINGTON, KANSAS 67514
PHONE NO.: 316-538-3246

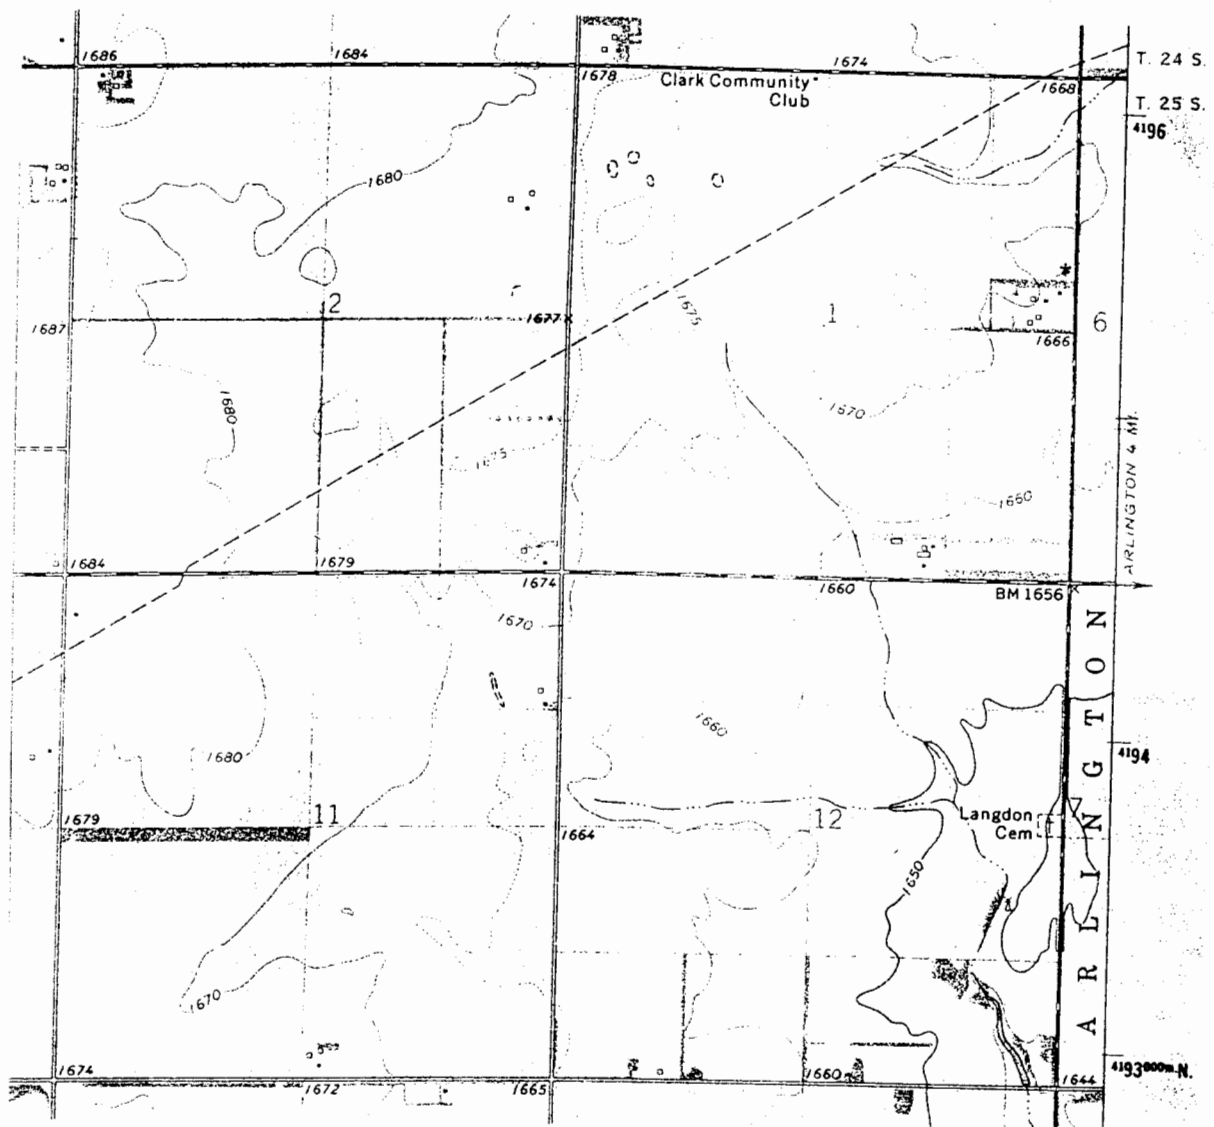

WELL LOCATION *