

[illegible]

INSTRUCTIONS: Use typewriter or ball point pen, *please press firmly* and *PRINT* clearly. Please fill in blanks, underline or circle the correct answers. Send top three copies to Kansas Department of Health and Environment, Division of Environment, Water Well Contractors, Topeka, KS 66620. Send one to WATER WELL OWNER and retain one for your records.

BIG BEND GMD#5-KGS
WATER QUALITY
OBSERVATION WELL
NETWORK

SITE NUMBER : 28
SITE LOCATION: SE SE NE


LEGAL LOCATION: 1-25-9W
COUNTY : RENO

WELL LOG

[illegible]

SITE NUMBER : 28
SITE LOCATION : SE SE NE
LEGAL LOCATION: SEC1 T25S R9W
COUNTY : RENO

LANDOWNER: CARL H. BREIDENSTEIN
ADDRESS : RURAL ROUTE 1
ARLINGTON, KANSAS 67514
PHONE NO.: 316-538-3246

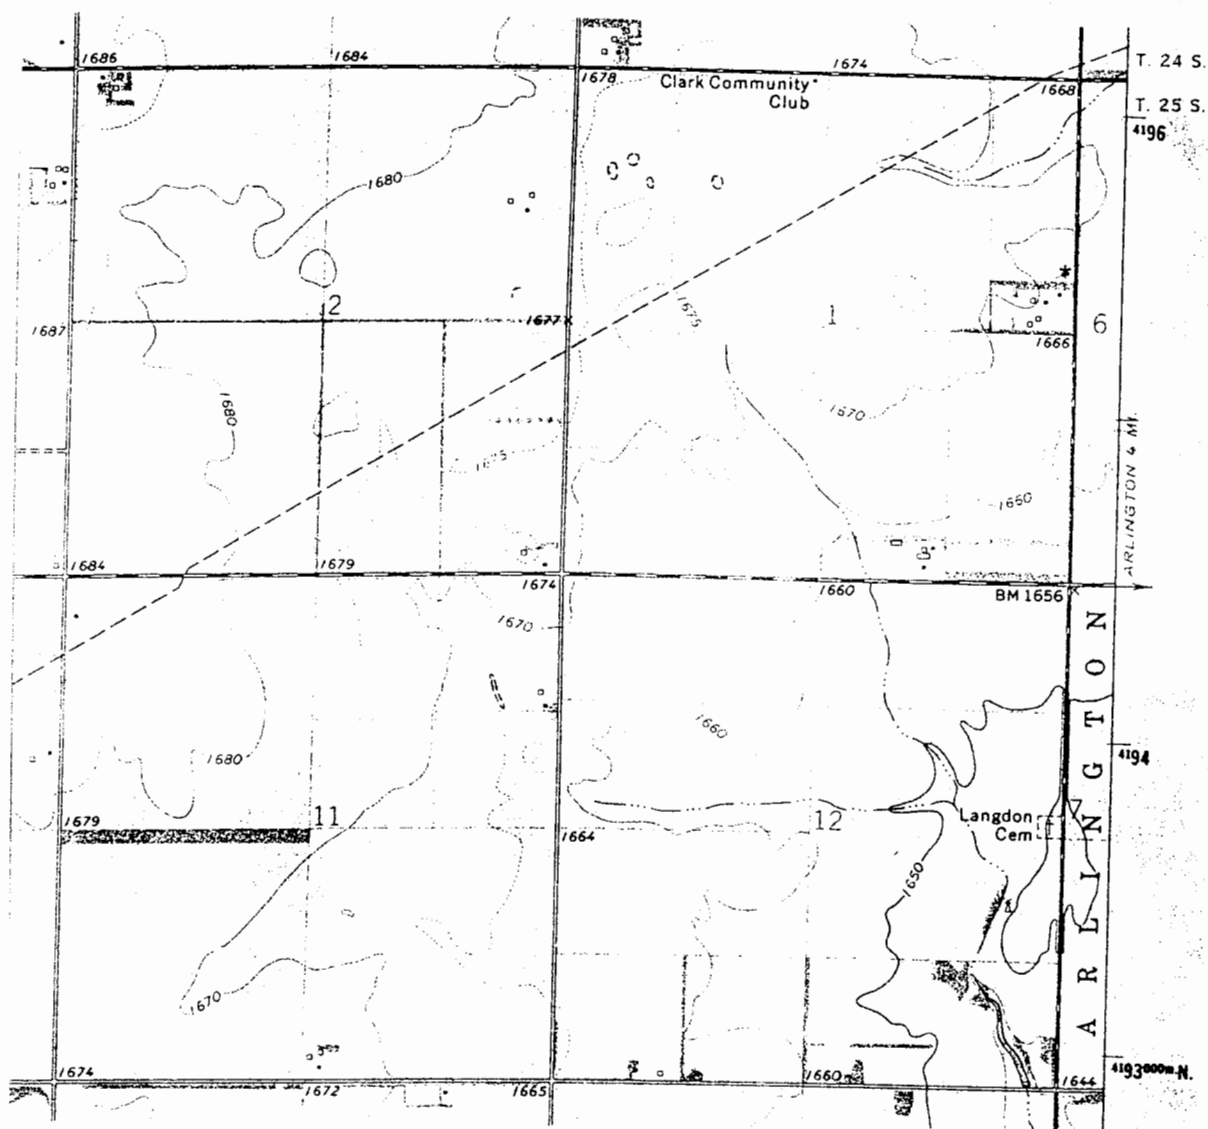

WELL LOCATION *