

Site 34 well #3

WATER WELL RECORD Form WWC-5 KSA 82a-1212

LOCATION OF WATER WELL	Fraction	Section Number	Township Number	Range Number
County: <u>Peno</u>	<u>SW 1/4 SE 1/4 SE 1/4</u>	<u>36</u>	<u>T 25 S</u>	<u>R 9 E(W)</u>

Distance and direction from nearest town or city?

2 mi. S. and 3 1/2 mi. E. of Langdon

Street address of well if located within city?

WATER WELL OWNER: K&S

R#, St. Address, Box #

City, State, ZIP Code

Board of Agriculture, Division of Water Resources
Application Number:DEPTH OF COMPLETED WELL: 53 ft. Bore Hole Diameter: 9 7/8 in. to 53 ft., and in. to

Well Water to be used as:

5 Public water supply

8 Air conditioning

11 Injection well

1 Domestic 3 Feedlot

6 Oil field water supply

9 Dewatering

(12) Other (Specify below)

2 Irrigation 4 Industrial

7 Lawn and garden only

10 Observation well

ResearchWell's static water level: 9.7 ft. below land surface measured on Jan month 28 day 1983 year

Pump Test Data

Well water was

ft. after

hours pumping

gpm

Est. Yield

gpm

Well water was

ft. after

hours pumping

gpm

TYPE OF BLANK CASING USED:

1 Steel

3 RMP (SR)

5 Wrought iron

8 Concrete tile

Casing Joints: Glued ☒ Clamped

(2) PVC

4 ABS

6 Asbestos-Cement

9 Other (specify below)

Welded

7 Fiberglass

Threaded

Blank casing dia: 5 in. to ft., Dia in. to ft., Dia in. toCasing height above land surface: 1.2 in., weight lbs./ft. Wall thickness or gauge No. Schedule 1120

TYPE OF SCREEN OR PERFORATION MATERIAL:

1 Steel

3 Stainless steel

5 Fiberglass

(1) PVC

10 Asbestos-cement

2 Brass

4 Galvanized steel

6 Concrete tile

8 RMP (SR)

11 Other (specify)

9 ABS

12 None used (open hole)

Screen or Perforation Openings Are:

1 Continuous slot

(3) Mill slot

5 Gauzed wrapped

8 Saw cut

11 None (open hole)

2 Louvered shutter

4 Key punched

6 Wire wrapped

9 Drilled holes

7 Torch cut

10 Other (specify)

Screen-Perforation Dia: 5 in. to ft., Dia in. to ft., Dia in. toScreen-Perforated Intervals: From 53 ft. to 48 ft., From ft. to ft., From ft. to ft.Gravel Pack Intervals: From 53 ft. to 41 ft., From ft. to ft., From ft. to ft.

From ft. to ft., From ft. to ft., From ft. to ft.

GROUT MATERIAL:

(1) Neat cement

2 Cement grout

3 Bentonite

4 Other

Grouted Intervals: From 41 ft. to 17 ft., From ft. to ft., From ft. to ft.

What is the nearest source of possible contamination:

1 Septic tank

4 Cess pool

7 Sewage lagoon

10 Fuel storage

14 Abandoned water well

2 Sewer lines

5 Seepage pit

8 Feed yard

11 Fertilizer storage

15 Oil well/Gas well

3 Lateral lines

6 Pit privy

9 Livestock pens

12 Insecticide storage

16 Other (specify below)

13 Watertight sewer lines

Direction from well: How many feet? Water Well Disinfected? Yes No

Was a chemical/bacteriological sample submitted to Department? Yes No: If yes, date sample

was submitted month day year: Pump Installed? Yes No

If Yes: Pump Manufacturer's name Model No. HP Volts

Depth of Pump Intake ft. Pumps Capacity rated at gal./min.

Type of pump: 1 Submersible 2 Turbine 3 Jet 4 Centrifugal 5 Reciprocating 6 Other

CONTRACTOR'S OR LANDOWNER'S CERTIFICATION: This water well was (1) constructed, (2) reconstructed, or (3) plugged under my jurisdiction and was


completed on June month 7 day 1982 year

and this record is true to the best of my knowledge and belief. Kansas Water Well Contractor's License No.

This Water Well Record was completed on month day year under the business

name of by (signature)

LOCATE WELL'S LOCATION WITH AN "X" IN SECTION BOX:

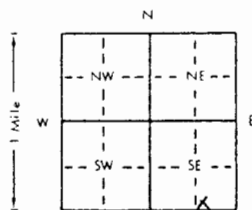

FROM TO LITHOLOGIC LOG FROM TO LITHOLOGIC LOG

0 10 reddish brown sandy clay

10 21 grey sandy clay with thin sand

21 22 lenses

22 25 partially lithified clay and

limestone

25 29 fine to med. grained sand, little

gravel

29 34 H. grey to yellow-grey

silty clay

34 53 sand, little gravel

red shale

ELEVATION: 1653.3

Depth(s) Groundwater Encountered 1. ft. 2. ft. 3. ft. 4. ft. (Use a second sheet if needed)

INSTRUCTIONS: Use typewriter or ball point pen, please press firmly and PRINT clearly. Please fill in blanks, underline or circle the correct answers. Send top three copies to Kansas Department of Health and Environment, Division of Environment, Water Well Contractors, Topeka, KS 66620. Send one to WATER WELL OWNER and retain one for your records.

BIG BEND GMD#5-KGS
WATER QUALITY
OBSERVATION WELL
NETWORK

SITE NUMBER : 34 (KP9)
SITE LOCATION: SW SE SE


LEGAL LOCATION: 36-25-9W
COUNTY : RENO

WELL LOG

[illegible]

SITE NUMBER : 34 (KP9)
SITE LOCATION : SW SE SE
LEGAL LOCATION: 36-25-9W
COUNTY : RENO

LANDOWNER: LUCILLE NIEDENTHAL
ADDRESS : RT 1
RUSSELL, KS
PHONE NO.: (913)-483-4079
TENENT: VERNON KRAUS
(316)-459-6345

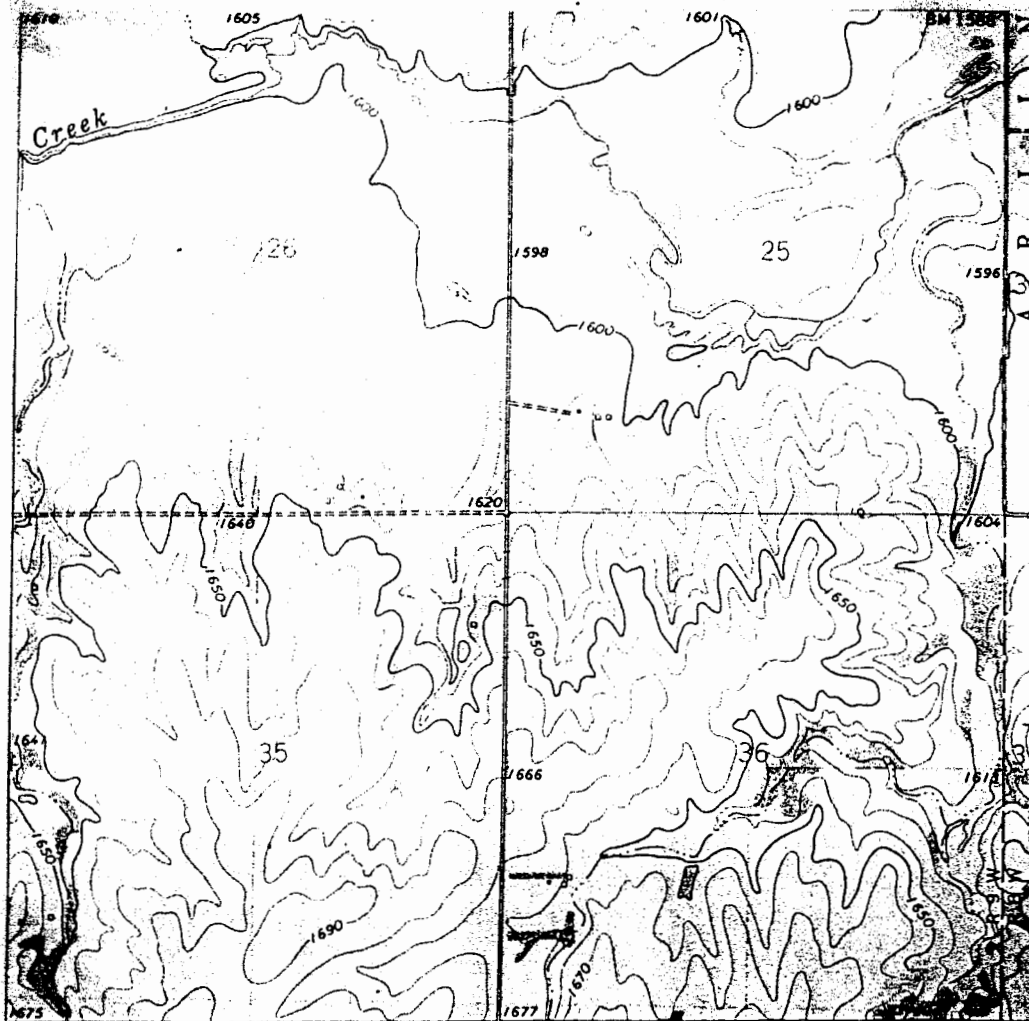

WELL LOCATION • *actual