

Site 34, well #2

WATER WELL RECORD

Form WWC-5

KSA 82a-1212

LOCATION OF WATER WELL	Fraction	Section Number	Township Number	Range Number
County: <u>Reno</u>	<u>SW 1/4</u> <u>SE 1/4</u> <u>SE 1/4</u>	<u>36</u>	<u>T 25 S</u>	<u>R 9 E</u> <u>W</u>

Distance and direction from nearest town or city?

2 mi. S, 3 1/2 mi. E of Langdon

Street address of well if located within city?

WATER WELL OWNER: KGS

R#, St. Address, Box #

City, State, ZIP Code

Board of Agriculture, Division of Water Resources

Application Number:

DEPTH OF COMPLETED WELL: 34 ft. Bore Hole Diameter: 9 7/8 in. to 34 ft. and in. to in.

Well Water to be used as:

- | | | | | |
|--------------|--------------|--------------------------|---------------------|--------------------------|
| 1 Domestic | 3 Feedlot | 5 Public water supply | 8 Air conditioning | 11 Injection well |
| 2 Irrigation | 4 Industrial | 6 Oil field water supply | 9 Dewatering | 12 Other (Specify below) |
| | | 7 Lawn and garden only | 10 Observation well | <u>Research</u> |

Well's static water level: 9.4 ft. below land surface measured on Jan month 28 day 1983 year

Pump Test Data

Well water was ft. after hours pumping. gpmTest Yield: gpm. Well water was ft. after hours pumping. gpm

TYPE OF BLANK CASING USED:

- | | | | | |
|--------------|------------|-------------------|-------------------------|---|
| 1 Steel | 3 RMP (SR) | 5 Wrought iron | 8 Concrete tile | Casing Joints: <u>X</u> Glued <u> </u> Clamped <u> </u> |
| <u>2 PVC</u> | 4 ABS | 6 Asbestos-Cement | 9 Other (specify below) | <u> </u> Welded <u> </u> |
| | | 7 Fiberglass | | <u> </u> Threaded <u> </u> |

Blank casing dia: 5 in. to ft., Dia in. to ft., Dia in. to in.Casing height above land surface: 12 in., weight lbs./ft. Wall thickness or gauge No Schedule 1120

TYPE OF SCREEN OR PERFORATION MATERIAL:

- | | | | | |
|---------|--------------------|-----------------|------------|--------------------------|
| 1 Steel | 3 Stainless steel | 5 Fiberglass | 8 RMP (SR) | 10 Asbestos-cement |
| 2 Brass | 4 Galvanized steel | 6 Concrete tile | 9 ABS | 11 Other (specify) |
| | | | | 12 None used (open hole) |

Screen or Perforation Openings Are:

- | | | | | |
|--------------------|--------------------|------------------|--------------------|---------------------|
| 1 Continuous slot | <u>2</u> Mill slot | 5 Gauzed wrapped | 8 Saw cut | 11 None (open hole) |
| 2 Louvered shutter | 4 Key punched | 6 Wire wrapped | 9 Drilled holes | |
| | | 7 Torch cut | 10 Other (specify) | |

Screen-Perforation Dia: 5 in. to ft., Dia in. to ft., Dia in. to in.Screen-Perforated Intervals: From 34 ft. to 29 ft., From ft. to ft., From ft. to ft., From ft. to ft.Gravel Pack Intervals: From 34 ft. to 24 ft., From ft. to ft., From ft. to ft., From ft. to ft.Grout Material: 1 Neat cement 2 Cement grout 3 Bentonite 4 Other Grouted Intervals: From 24 ft. to 14 ft., From ft. to ft., From ft. to ft., From ft. to ft.

What is the nearest source of possible contamination:

- | | | | | |
|-----------------|---------------|------------------|---------------------------|--------------------------|
| 1 Septic tank | 4 Cess pool | 7 Sewage lagoon | 10 Fuel storage | 14 Abandoned water well |
| 2 Sewer lines | 5 Seepage pit | 8 Feed yard | 11 Fertilizer storage | 15 Oil well/Gas well |
| 3 Lateral lines | 6 Pit privy | 9 Livestock pens | 12 Insecticide storage | 16 Other (specify below) |
| | | | 13 Watertight sewer lines | |

Direction from well: How many feet: ? Water Well Disinfected? Yes No Has a chemical/bacteriological sample submitted to Department? Yes No If yes, date samplewas submitted: month day year: Pump Installed? Yes No If Yes: Pump Manufacturer's name: Model No. HP Volts Depth of Pump Intake: ft. Pumps Capacity rated at gal./min

Type of pump: 1 Submersible 2 Turbine 3 Jet 4 Centrifugal 5 Reciprocating 6 Other

CONTRACTOR'S OR LANDOWNER'S CERTIFICATION: This water well was (1) constructed, (2) reconstructed, or (3) plugged under my jurisdiction and wascompleted on June month 7 day 1982 yearand this record is true to the best of my knowledge and belief. Kansas Water Well Contractor's License No. This Water Well Record was completed on month day year under the businessname of by (signature)

LOCATE WELL'S LOCATION WITH AN "X" IN SECTION BOX:

FROM TO LITHOLOGIC LOG FROM TO LITHOLOGIC LOG

0 10 reddish brown sandy clay10 21 grey sandy clay with thin sand lenses21 22 partially lithified clay and limestone22 25 fine to med. grained sand, little gravel25 29 H. grey to yellow-grey silty clay29 34 sand, little gravel (abbreviated log)ELEVATION: 1653.5Depth(s) Groundwater Encountered 1. ft. 2. ft. 3. ft. 4. ft. (Use a second sheet if needed)

INSTRUCTIONS: Use typewriter or ball point pen, please press firmly and PRINT clearly. Please fill in blanks, underline or circle the correct answers. Send top three copies to Kansas Department of Health and Environment, Division of Environment, Water Well Contractors, Topeka, KS 66620. Send one to WATER WELL OWNER and retain one for your records.


LEGAL LOCATION: 36-25-9W
COUNTY : RENO

WELL LOG

[illegible]

SITE NUMBER : 34 (KP9)
SITE LOCATION : SW SE SE
LEGAL LOCATION: 36-25-9W
COUNTY : RENO

LANDOWNER: LUCILLE NIEDENTHAL
ADDRESS : RT 1
RUSSELL, KS
PHONE NO.: (913)-483-4079
TENENT: VERNON KRAUS
(316)-459-6345

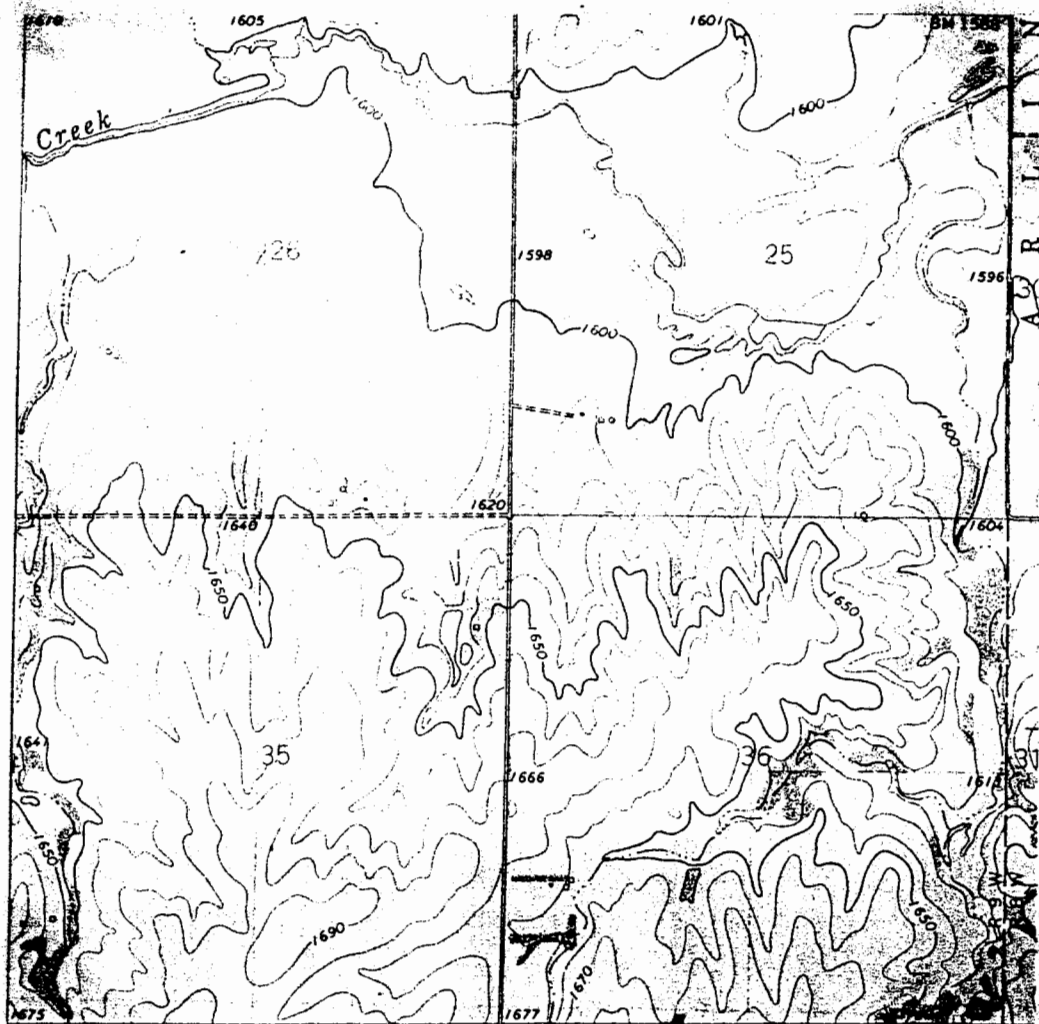

WELL LOCATION • * actual