

County: Reno Fraction: NW Sec. 20 T 25 S R 9 E (NW)

CORRECTION(S) TO WATER WELL COMPLETION RECORD (WWC-5)
(to rectify lacking or incorrect information)

Owner: Preisser, Larry

Location was listed as:

Section-Township-Range: 20 - 27 S - 9W

Fraction (1/4 1/4 1/4): NW

Location changed to:

20 - 25 S - 9W

NW

Other changes: Initial statements: _____

Changed to: _____

Comments: _____

Verification method: WWC5 Database to find well #3 that was drilled the same day, changed Township to 25 and Road intersection matched.

Submitted by: _____ initials: DF date: 4/15/14
to: Kansas Geological Survey, Data Resources Library, 1930 Constant Ave., Lawrence KS 66047-3726
to: Kansas Dept of Health & Environment, Bureau of Water, 1000 SW Jackson, Suite 420, Topeka, KS 66612-1367.

P

WATER WELL RECORD

Form WWC-5


Division of Water Resources App. No.

33272

1 LOCATION OF WATER WELL: County: ~~Frank~~ **Reno** Fraction: 1/4 1/4 1/4 NW 1/4 Section Number: 20 Township No.: T 27 S Range Number: R 9 E W

Street/Rural Address of Well Location; if unknown, distance & direction from nearest town or intersection: If at owner's address, check here S Landon Rd & Castleton
 Global Positioning System (GPS) information:
 Latitude: (in decimal degrees)
 Longitude: (in decimal degrees)
 Elevation:
 Datum: WGS 84, NAD 83, NAD 27
 Collection Method:
 GPS unit (Make/Model:)
 Digital Map/Photo, Topographic Map, Land Survey
 Est. Accuracy: <3 m, 3-5 m, 5-15 m, >15 m

2 WATER WELL OWNER: Larry Preisser
 RR#, Street Address, Box #: 105 SE 130th Ave
 City, State, ZIP Code: Cunningham, KS 67035

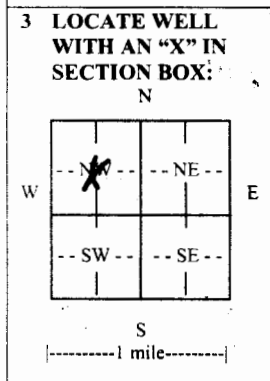

4 DEPTH OF COMPLETED WELL 70 ft.
 Depth(s) Groundwater Encountered (1) 15 ft. (2) ft. (3) ft.
 WELL'S STATIC WATER LEVEL 15 ft. below land surface measured on mo/day/yr
 Pump test data: Well water was ft. after hours pumping gpm
 EST. YIELD 800 gpm. Well water was ft. after hours pumping gpm
 Bore Hole Diameter 40 in. to 70 ft., and in. to ft.
 WELL WATER TO BE USED AS: Public water supply Geothermal Injection well
 Domestic Feedlot Oil field water supply Dewatering Other (Specify below)
 Irrigation Industrial Domestic-lawn & garden Monitoring well
 Was a chemical/bacteriological sample submitted to Department? Yes No
 If yes, mo/day/yr sample was submitted.
 Water well disinfected? Yes No

5 TYPE OF CASING USED: Steel PVC Other
 CASING JOINTS: Glued Clamped Welded Threaded
 Casing diameter 16 in. to 70 ft., Diameter in. to ft., Diameter in. to ft.
 Casing height above land surface 12 in., Weight 16 lbs./ft., Wall thickness or gauge No. SCH40
 TYPE OF SCREEN OR PERFORATION MATERIAL:
 Steel Stainless Steel PVC Other (Specify)
 Brass Galvanized Steel None used (open hole)
 SCREEN OR PERFORATION OPENINGS ARE:
 Continuous slot Mill slot Gauze wrapped Torch cut Drilled holes None (open hole)
 Louvered shutter Key punched Wire wrapped Saw cut Other (specify)
 SCREEN-PERFORATED INTERVALS: From 30 ft. to 70 ft., From ft. to ft.
 GRAVEL PACK INTERVALS: From 20 ft. to 70 ft., From ft. to ft.
 From ft. to ft., From ft. to ft.

6 GROUT MATERIAL: Neat cement Cement grout Bentonite Other
 Grout Intervals: From 3 ft. to 20 ft., From ft. to ft., From ft. to ft.
 What is the nearest source of possible contamination:
 Septic tank Lateral lines Pit privy Livestock pens Insecticide storage Other (specify below)
 Sewer lines Cesspool Sewage lagoon Fuel storage Abandoned water well
 Watertight sewer lines Seepage pit Feedyard Fertilizer storage Oil well/gas well Old Well
 Direction from well Southwest Distance from well .25

FROM	TO	LITHOLOGIC LOG	FROM	TO	LITHO. LOG (cont.) or PLUGGING INTERVALS
0	2	Sandy Topsoil	58	70	Good Sand
2	5	Clay	70		Red Bed
5	16	Sand & Gravel			
16	18	Clay			
18	48	Good Sand & Gravel			
48	49	Clay			
49	51	Sand			
51	52	Clay			
52	57	Sand-Good			
57	58	Clay			

7 CONTRACTOR'S OR LANDOWNER'S CERTIFICATION: This water well was constructed, reconstructed, or plugged under my jurisdiction and was completed on (mo/day/year) 01/22/2014 and this record is true to the best of my knowledge and belief.
 Kansas Water Well Contractor's License No. 238 This Water Well Record was completed on (mo/day/year) 01/27/2014 under the business name of Premier Pump & Well Service, Inc by (signature) *Mervyn A. ...*

INSTRUCTIONS: Use typewriter or ball point pen. PLEASE PRESS FIRMLY and PRINT clearly. Please fill in blanks and check the correct answers. Send one copy to Kansas Department of Health and Environment, Bureau of Water, Geology Section, 1000 SW Jackson St., Suite 420, Topeka, Kansas 66612-1367. Telephone 785-296-5524. Send one copy to WATER WELL OWNER and retain one for your records. Include fee of \$5.00 for each constructed well. Visit us at <http://www.kdheks.gov/waterwell/index.html>