


Correction

WATER WELL PLUGGING RECORD Form WWC-5P KSA 82a-1212 ID NO.

**1 LOCATION OF WATER WELL:** Fraction NW 1/4 NW 1/4 SW 1/4 SW 1/4 Section Number 17 Township Number 25 T S Range Number 9  E  W  
 County: Reno  
 Street/Rural Address of Well Location; if unknown, distance & direction from nearest town or intersection: If at owner's address, check here  North of S.Huntsville/ W. Castleton Rd., Langdon, KS  
**Global Positioning Systems (GPS) information:**  
 Latitude: 37.870955 (in decimal degrees)  
 Longitude: 98.342401 (in decimal degrees)  
 Elevation: 1710  
 Datum:  WGS84,  NAD83,  NAD27  
 Collection Method:

**2 WATER WELL OWNER:** Enterprise Products Operating, RR#, St. Address, Box #: P.O. Box 4735 City, State ZIP Code: Houston Texas 77210  
 GPS unit (Make/Model: \_\_\_\_\_)  
 Digital Map/Photo,  Topographic Map,  Land Survey  
 Est. Accuracy:  < 3 m,  3-5 m,  5-15 m,  > 15 m

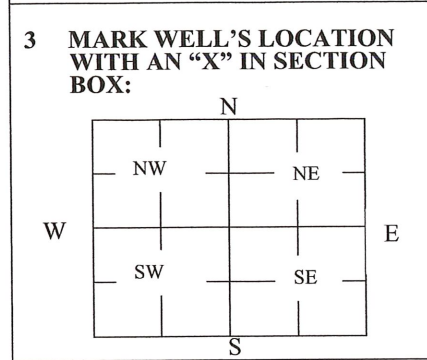

**4 DEPTH OF WELL** 23.0 ft.  
 WELL'S STATIC WATER LEVEL 13.16 ft  
 WELL WAS USED AS:  
 Domestic  Public Water Supply  Dewatering  
 Irrigation  Oil Field Water Supply  Monitoring  
 Feedlot  Domestic (Lawn & Garden)  Injection Well  
 Industrial  Air Conditioning  Other \_\_\_\_\_  
 Was a chemical/bacteriological sample submitted to Department? Yes  No

**5 TYPE OF BLANK CASING USED:**  
 Steel  RMP (SR)  Wrought  Fiberglass  Other (Specify below)  
 PVC  ABS  Asbestos-Cement  Concrete Tile  
 Blank casing diameter 2.0 in. Was casing pulled? Yes  No  If yes, how much All  
 Casing height above or below land surface 36.0 in.

**6 GROUT PLUG MATERIAL:**  Neat cement  Cement grout  Bentonite  Other Topsoil  
 Grout Plug Intervals: From 0 ft. to 23.0 ft., From 1.0' ft. to 23.0' ft., From \_\_\_\_\_ ft. to \_\_\_\_\_ ft.  
 What is the nearest source of possible contamination:  
 Septic tank  Seepage pit  Fuel storage  Other (specify below) Fertilized Land  
 Sewer lines  Pit privy  Fertilizer storage  
 Watertight sewer lines  Sewage lagoon  Insecticide storage  
 Lateral lines  Feedyard  Abandoned water well Direction from well? South  
 Cess pool  Livestock pens  Oil well/Gas well How many feet? 50

FROM	TO	PLUGGING MATERIALS	FROM	TO	PLUGGING MATERIALS
0	1.0	Topsoil			
1.0	23.0	3/8 Bentonite Chips			

**7 CONTRACTOR'S OR LANDOWNER'S CERTIFICATION:** This water well was plugged under my jurisdiction and was completed on (mo/day/year) 12/17/2019 and this record is true to the best of my knowledge and belief. Kansas Water Well Contractor's License No. 606. This Water Well Record was completed on (mo/day/year) 02/05/2020 under the business name of Dakota Technologies Company, LLC by (signature)

Send one white copy to Kansas Department of Health & Environment, Geology Section, 1000 SW Jackson Street, Ste. 420, Topeka, KS 66612-1367. Send one copy to WATER WELL OWNER and retain one for your records.  
 Visit us at Telephone 785-296-5524.