

Correction

WATER WELL PLUGGING RECORD Form WWC-5P KSA 82a-1212 ID NO. MW-01

1 LOCATION OF WATER WELL: County: Reno Fraction NE 1/4 NE 1/4 SE 1/4 SE 1/4 Section Number 18 Township Number 25 T S Range Number 9 E W

Street/Rural Address of Well Location; if unknown, distance & direction from nearest town or intersection: If at owner's address, check here [ ] North of S. Huntsville/ W. Castleton Rd., Langdon, KS Global Positioning Systems (GPS) information: Latitude: 37.871312 (in decimal degrees) Longitude: 98.343658 (in decimal degrees) Elevation: 1710 Datum: [x] WGS84, [ ] NAD83, [ ] NAD27 Collection Method:

2 WATER WELL OWNER: Enterprise Products Operating, RR#, St. Address, Box #: P.O. Box 4735 City, State ZIP Code: Houston Texas 77210 Est. Accuracy: [x] < 3 m, [ ] 3-5 m, [ ] 5-15 m, [ ] > 15 m

3 MARK WELL'S LOCATION WITH AN "X" IN SECTION BOX: [Diagram of a 3x3 grid with NW, NE, SW, SE quadrants and N, S, E, W directions] 4 DEPTH OF WELL 19.75 20.0 ft. WELL'S STATIC WATER LEVEL 13.81 ft. WELL WAS USED AS: [ ] Domestic [ ] Irrigation [ ] Feedlot [ ] Industrial [ ] Public Water Supply [ ] Oil Field Water Supply [ ] Domestic (Lawn & Garden) [ ] Air Conditioning [ ] Dewatering [x] Monitoring [ ] Injection Well [ ] Other Was a chemical/bacteriological sample submitted to Department? Yes [ ] No [x]

5 TYPE OF BLANK CASING USED: [x] Steel [ ] PVC [ ] RMP (SR) [ ] ABS [ ] Wrought [ ] Asbestos-Cement [ ] Fiberglass [ ] Concrete Tile [ ] Other (Specify below) Blank casing diameter 2.0 in. Was casing pulled? Yes [x] No [ ] If yes, how much 10.0 Casing height above or below land surface 120 in.

6 GROUT PLUG MATERIAL: [ ] Neat cement [ ] Cement grout [x] Bentonite [x] Other Topsoil Grout Plug Intervals: From 0 ft. to 1.0 ft., From 1.0 ft. to 20.0 ft., From \_\_\_ ft. to \_\_\_ ft. What is the nearest source of possible contamination: [ ] Septic tank [ ] Sewer lines [ ] Watertight sewer lines [ ] Lateral lines [ ] Cess pool [ ] Seepage pit [ ] Pit privy [ ] Sewage lagoon [ ] Feedyard [ ] Livestock pens [ ] Fuel storage [ ] Fertilizer storage [ ] Insecticide storage [ ] Abandoned water well [ ] Oil well/Gas well [x] Other (specify below) Fertilized Land Direction from well? West How many feet? 30.0

Table with columns: FROM, TO, PLUGGING MATERIALS. Row 1: 0, 1.0, Topsoil. Row 2: 1.0, 19.75, 3/8 Bentonite Chips. Row 3: 19.75, 20.0, (blank).

7 CONTRACTOR'S OR LANDOWNER'S CERTIFICATION: This water well was plugged under my jurisdiction and was completed on (mo/day/year) 12/18/2019 and this record is true to the best of my knowledge and belief. Kansas Water Well Contractor's License No. 606. This Water Well Record was completed on (mo/day/year) 02/05/2020 under the business name of Dakota Technologies Company, LLC by (signature)

Send one white copy to Kansas Department of Health & Environment, Geology Section, 1000 SW Jackson Street, Ste. 420, Topeka, KS 66612-1367. Send one copy to WATER WELL OWNER and retain one for your records. Visit us at Telephone 785-296-5524.

Correction

MW-02

**WATER WELL PLUGGING RECORD Form WWC-5P KSA 82a-1212 ID NO.**

<b>1 LOCATION OF WATER WELL:</b> County: Reno	Fraction NE ¼ NE ¼ SE ¼ SE ¼	Section Number 18	Township Number 25 T S	Range Number 9 <input type="checkbox"/> E <input type="checkbox"/> W
Street/Rural Address of Well Location; if unknown, distance & direction from nearest town or intersection: If at owner's address, check here <input type="checkbox"/> North of S. Huntsville/ W. Castleton Rd., Langdon, KS		<b>Global Positioning Systems (GPS) information:</b> Latitude: 37.871187 (in decimal degrees) Longitude: 98.343662 (in decimal degrees) Elevation: 1710 Datum: <input checked="" type="checkbox"/> WGS84, <input type="checkbox"/> NAD83, <input type="checkbox"/> NAD27 Collection Method: <input type="checkbox"/> GPS unit (Make/Model: _____) <input checked="" type="checkbox"/> Digital Map/Photo, <input type="checkbox"/> Topographic Map, <input type="checkbox"/> Land Survey Est. Accuracy: <input checked="" type="checkbox"/> < 3 m, <input type="checkbox"/> 3-5 m, <input type="checkbox"/> 5-15 m, <input type="checkbox"/> > 15 m		
<b>2 WATER WELL OWNER:</b> Enterprise Products Operating, RR#, St. Address, Box #: P.O. Box 4735 City, State ZIP Code: Houston Texas 77210				

<b>3 MARK WELL'S LOCATION WITH AN "X" IN SECTION BOX:</b>	<b>4 DEPTH OF WELL</b> <del>49.75</del> <u>20.0</u> ft. WELL'S STATIC WATER LEVEL <u>13.56</u> ft WELL WAS USED AS: <input type="checkbox"/> Domestic <input type="checkbox"/> Public Water Supply <input type="checkbox"/> Dewatering <input type="checkbox"/> Irrigation <input type="checkbox"/> Oil Field Water Supply <input checked="" type="checkbox"/> Monitoring <input type="checkbox"/> Feedlot <input type="checkbox"/> Domestic (Lawn & Garden) <input type="checkbox"/> Injection Well <input type="checkbox"/> Industrial <input type="checkbox"/> Air Conditioning <input type="checkbox"/> Other _____ Was a chemical/bacteriological sample submitted to Department? Yes <input type="checkbox"/> No <input checked="" type="checkbox"/>
---	---

**5 TYPE OF BLANK CASING USED:**

Steel  RMP (SR)  Wrought  Fiberglass  Other (Specify below)  
 PVC  ABS  Asbestos-Cement  Concrete Tile

Blank casing diameter 2.0 in. Was casing pulled? Yes  No  If yes, how much 14.0  
 Casing height above or below land surface ~~0~~ 168 in.

**6 GROUT PLUG MATERIAL:**  Neat cement  Cement grout  Bentonite  Other Topsoil

Grout Plug Intervals: From 0 ft. to ~~19.75~~ 20.0 ft., From 1.0 ft. to 20.0 ft., From \_\_\_\_\_ ft. to \_\_\_\_\_ ft.

What is the nearest source of possible contamination:  
 Septic tank  Seepage pit  Fuel storage  Other (specify below)  
 Sewer lines  Pit privy  Fertilizer storage Fertilized Land  
 Watertight sewer lines  Sewage lagoon  Insecticide storage  
 Lateral lines  Feedyard  Abandoned water well  
 Cess pool  Livestock pens  Oil well/Gas well  
 Direction from well? West  
 How many feet? 30.0

FROM	TO	PLUGGING MATERIALS	FROM	TO	PLUGGING MATERIALS
0	1.0	Topsoil			
1.0	<del>19.75</del> <u>20.0</u>	3/8 Bentonite Chips			

**7 CONTRACTOR'S OR LANDOWNER'S CERTIFICATION:** This water well was plugged under my jurisdiction and was completed on (mo/day/year) 12/18/2019 and this record is true to the best of my knowledge and belief. Kansas Water Well Contractor's License No. 606. This Water Well Record was completed on (mo/day/year) 02/05/2020 under the business name of Dakota Technologies Company, LLC by (signature) \_\_\_\_\_

Send one white copy to Kansas Department of Health & Environment, Geology Section, 1000 SW Jackson Street, Ste. 420, Topeka, KS 66612-1367. Send one copy to WATER WELL OWNER and retain one for your records.  
 Visit us at Telephone 785-296-5524.

Correction

MW-05

WATER WELL PLUGGING RECORD Form WWC-5P KSA 82a-1212 ID NO.

**1 LOCATION OF WATER WELL:** Fraction NE 1/4 NE 1/4 SE 1/4 SE 1/4 Section Number 18 Township Number 25 T S Range Number 9  E  W  
 County: Reno

Street/Rural Address of Well Location; if unknown, distance & direction from nearest town or intersection: If at owner's address, check here  North of S.Huntsville/ W. Castleton Rd., Langdon, KS

**Global Positioning Systems (GPS) information:**  
 Latitude: 37.870886 (in decimal degrees)  
 Longitude: 98.343866 (in decimal degrees)  
 Elevation: 1710  
 Datum:  WGS84,  NAD83,  NAD27  
 Collection Method:  
 GPS unit (Make/Model: \_\_\_\_\_)  
 Digital Map/Photo,  Topographic Map,  Land Survey  
 Est. Accuracy:  < 3 m,  3-5 m,  5-15 m,  > 15 m

**2 WATER WELL OWNER:** Enterprise Products Operating, RR#, St. Address, Box #: P.O. Box 4735 City, State ZIP Code: Houston Texas 77210

**3 MARK WELL'S LOCATION WITH AN "X" IN SECTION BOX:**

	N	
NW		NE
W		E
SW		SE
	S	

**4 DEPTH OF WELL** 22.75 20.0 ft.  
 WELL'S STATIC WATER LEVEL 15.39 ft  
 WELL WAS USED AS:  
 Domestic Irrigation Feedlot Industrial  
 Public Water Supply Oil Field Water Supply Domestic (Lawn & Garden) Air Conditioning  
 Dewatering Monitoring Injection Well Other \_\_\_\_\_  
 Was a chemical/bacteriological sample submitted to Department? Yes  No

**5 TYPE OF BLANK CASING USED:**

Steel  RMP (SR)  Wrought  Fiberglass  Other (Specify below)  
 PVC  ABS  Asbestos-Cement  Concrete Tile

Blank casing diameter 2.0 in. Was casing pulled? Yes  No  If yes, how much 9.0  
 Casing height above or below land surface 0 108 in.

**6 GROUT PLUG MATERIAL:**  Neat cement  Cement grout  Bentonite  Other Topsoil

Grout Plug Intervals: From 0 ft. to 22.75 ft., From 1.0 ft. to 20.0 ft., From \_\_\_\_\_ ft. to \_\_\_\_\_ ft.

What is the nearest source of possible contamination:  
 Septic tank  Seepage pit  Fuel storage  Other (specify below)  
 Sewer lines  Pit privy  Fertilizer storage Fertilized Land  
 Watertight sewer lines  Sewage lagoon  Insecticide storage  
 Lateral lines  Feedyard  Abandoned water well Direction from well? West  
 Cess pool  Livestock pens  Oil well/Gas well How many feet? 10.0

FROM	TO	PLUGGING MATERIALS	FROM	TO	PLUGGING MATERIALS
0	1.0	Topsoil			
1.0	<del>22.75</del>	3/8 Bentonite Chips			
	<u>20.0</u>				

**7 CONTRACTOR'S OR LANDOWNER'S CERTIFICATION:** This water well was plugged under my jurisdiction and was completed on (mo/day/year) 12/17/2019 and this record is true to the best of my knowledge and belief. Kansas Water Well Contractor's License No. 606. This Water Well Record was completed on (mo/day/year) 02/05/2020 under the business name of Dakota Technologies Company, LLC by (signature) \_\_\_\_\_

Send one white copy to Kansas Department of Health & Environment, Geology Section, 1000 SW Jackson Street, Ste. 420, Topeka, KS 66612-1367. Send one copy to WATER WELL OWNER and retain one for your records.  
 Visit us at Telephone 785-296-5524.

Correction

MW-09

WATER WELL PLUGGING RECORD Form WWC-5P KSA 82a-1212 ID NO.


**1 LOCATION OF WATER WELL:** County: Reno Fraction NE 1/4 NE 1/4 SE 1/4 SE 1/4 Section Number 18 Township Number 25 T S Range Number 9  E  W

Street/Rural Address of Well Location; if unknown, distance & direction from nearest town or intersection: If at owner's address, check here  North of S. Huntsville/ W. Castleton Rd., Langdon, KS

**Global Positioning Systems (GPS) information:**  
 Latitude: 37.871424 (in decimal degrees)  
 Longitude: 98.343662 (in decimal degrees)  
 Elevation: 1709  
 Datum:  WGS84,  NAD83,  NAD27  
 Collection Method:

**2 WATER WELL OWNER:** Enterprise Products Operating, RR#, St. Address, Box #: P.O. Box 4735 City, State ZIP Code: Houston Texas 77210

GPS unit (Make/Model: \_\_\_\_\_)  
 Digital Map/Photo,  Topographic Map,  Land Survey  
 Est. Accuracy:  < 3 m,  3-5 m,  5-15 m,  > 15 m

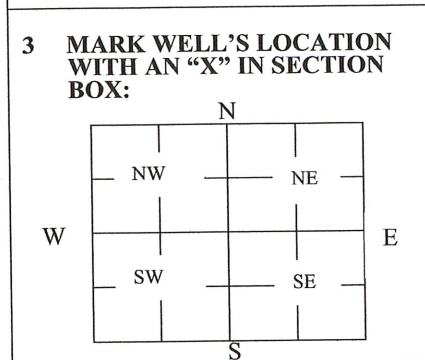

**4 DEPTH OF WELL** ~~19.0~~ 25.0' ft.  
 WELL'S STATIC WATER LEVEL 13.69 ft  
 WELL WAS USED AS:

Domestic  Public Water Supply  Dewatering  
 Irrigation  Oil Field Water Supply  Monitoring  
 Feedlot  Domestic (Lawn & Garden)  Injection Well  
 Industrial  Air Conditioning  Other \_\_\_\_\_

Was a chemical/bacteriological sample submitted to Department? Yes  No

**5 TYPE OF BLANK CASING USED:**

Steel  RMP (SR)  Wrought  Fiberglass  Other (Specify below) \_\_\_\_\_  
 PVC  ABS  Asbestos-Cement  Concrete Tile

Blank casing diameter 2.0 in. Was casing pulled? Yes  No  If yes, how much All  
 Casing height above or below land surface 0 in.

**6 GROUT PLUG MATERIAL:**  Neat cement  Cement grout  Bentonite  Other Topsoil

Grout Plug Intervals: From 0 ft. to ~~19.0~~ 1.0 ft., From 1.0 ft. to 25.0 ft., From \_\_\_\_\_ ft. to \_\_\_\_\_ ft.

What is the nearest source of possible contamination:

Septic tank  Seepage pit  Fuel storage  Other (specify below) Fertilized Land  
 Sewer lines  Pit privy  Fertilizer storage  
 Watertight sewer lines  Sewage lagoon  Insecticide storage  
 Lateral lines  Feedyard  Abandoned water well Direction from well? West  
 Cess pool  Livestock pens  Oil well/Gas well How many feet? 30.0

FROM	TO	PLUGGING MATERIALS	FROM	TO	PLUGGING MATERIALS
0	1.0	Topsoil			
1.0	<del>19.0</del>	3/8 Bentonite Chips			
	<u>25.0'</u>				

**7 CONTRACTOR'S OR LANDOWNER'S CERTIFICATION:** This water well was plugged under my jurisdiction and was completed on (mo/day/year) 12/18/2019 and this record is true to the best of my knowledge and belief. Kansas Water Well Contractor's License No. 606. This Water Well Record was completed on (mo/day/year) 02/05/2020 under the business name of Dakota Technologies Company, LLC by (signature) \_\_\_\_\_

Send one white copy to Kansas Department of Health & Environment, Geology Section, 1000 SW Jackson Street, Ste. 420, Topeka, KS 66612-1367. Send one copy to WATER WELL OWNER and retain one for your records.  
 Visit us at Telephone 785-296-5524.

Correction

MW-11

**WATER WELL PLUGGING RECORD Form WWC-5P KSA 82a-1212 ID NO.**

<b>1 LOCATION OF WATER WELL:</b> County: <u>Reno</u>	Fraction <u>SE 1/4 NE 1/4 SE 1/4 SE 1/4</u>	Section Number <u>18</u>	Township Number <u>25 T S</u>	Range Number <u>9</u> <input type="checkbox"/> E <input type="checkbox"/> W
Street/Rural Address of Well Location; if unknown, distance & direction from nearest town or intersection: If at owner's address, check here <input type="checkbox"/> <u>North of S.Huntsville/ W. Castleton Rd., Langdon, KS</u>		<b>Global Positioning Systems (GPS) information:</b> Latitude: <u>37.870715</u> (in decimal degrees) Longitude: <u>98.343653</u> (in decimal degrees) Elevation: <u>1711</u> Datum: <input checked="" type="checkbox"/> WGS84, <input type="checkbox"/> NAD83, <input type="checkbox"/> NAD27 Collection Method: <input type="checkbox"/> GPS unit (Make/Model: _____) <input checked="" type="checkbox"/> Digital Map/Photo, <input type="checkbox"/> Topographic Map, <input type="checkbox"/> Land Survey Est. Accuracy: <input checked="" type="checkbox"/> < 3 m, <input type="checkbox"/> 3-5 m, <input type="checkbox"/> 5-15 m, <input type="checkbox"/> > 15 m		
<b>2 WATER WELL OWNER:</b> Enterprise Products Operating, RR#, St. Address, Box #: P.O. Box 4735 City, State ZIP Code: <u>Houston Texas 77210</u>				

<b>3 MARK WELL'S LOCATION WITH AN "X" IN SECTION BOX:</b> <div style="text-align: center;">                 N  <table border="1" style="margin: auto; border-collapse: collapse;"> <tr><td style="width: 20px;">NW</td><td style="width: 20px;">NE</td></tr> <tr><td style="width: 20px;">SW</td><td style="width: 20px;">SE</td></tr> </table>                 W <span style="margin-left: 100px;">E</span>                  S             </div>	NW	NE	SW	SE	<b>4 DEPTH OF WELL</b> <del>24.50</del> <u>25.0'</u> ft. WELL'S STATIC WATER LEVEL <u>12.02</u> ft WELL WAS USED AS: <table style="width: 100%;"> <tr> <td><input type="checkbox"/> Domestic</td> <td><input type="checkbox"/> Public Water Supply</td> <td><input type="checkbox"/> Dewatering</td> </tr> <tr> <td><input type="checkbox"/> Irrigation</td> <td><input type="checkbox"/> Oil Field Water Supply</td> <td><input checked="" type="checkbox"/> Monitoring</td> </tr> <tr> <td><input type="checkbox"/> Feedlot</td> <td><input type="checkbox"/> Domestic (Lawn &amp; Garden)</td> <td><input type="checkbox"/> Injection Well</td> </tr> <tr> <td><input type="checkbox"/> Industrial</td> <td><input type="checkbox"/> Air Conditioning</td> <td><input type="checkbox"/> Other _____</td> </tr> </table> Was a chemical/bacteriological sample submitted to Department? Yes <input type="checkbox"/> No <input checked="" type="checkbox"/>	<input type="checkbox"/> Domestic	<input type="checkbox"/> Public Water Supply	<input type="checkbox"/> Dewatering	<input type="checkbox"/> Irrigation	<input type="checkbox"/> Oil Field Water Supply	<input checked="" type="checkbox"/> Monitoring	<input 

**5 TYPE OF BLANK CASING USED:**

Steel  RMP (SR)  Wrought  Fiberglass  Other (Specify below)  
 PVC  ABS  Asbestos-Cement  Concrete Tile

Blank casing diameter 2.0 in. Was casing pulled? Yes  No  If yes, how much 5.0

Casing height above or below land surface 0 ~~60~~ in.

**6 GROUT PLUG MATERIAL:**  Neat cement  Cement grout  Bentonite  Other Topsoil

Grout Plug Intervals: From 0 ft. to ~~24.50~~ 1.0 ft., From 1.0 ft. to 25.0' ft., From \_\_\_\_\_ ft. to \_\_\_\_\_ ft.

What is the nearest source of possible contamination:

<input type="checkbox"/> Septic tank	<input type="checkbox"/> Seepage pit	<input type="checkbox"/> Fuel storage	<input checked="" type="checkbox"/> Other (specify below)
<input type="checkbox"/> Sewer lines	<input type="checkbox"/> Pit privy	<input type="checkbox"/> Fertilizer storage	<u>Fertilized Land</u>
<input type="checkbox"/> Watertight sewer lines	<input type="checkbox"/> Sewage lagoon	<input type="checkbox"/> Insecticide storage	
<input type="checkbox"/> Lateral lines	<input type="checkbox"/> Feedyard	<input type="checkbox"/> Abandoned water well	Direction from well? <u>West</u>
<input type="checkbox"/> Cess pool	<input type="checkbox"/> Livestock pens	<input type="checkbox"/> Oil well/Gas well	How many feet? <u>10.0</u>

FROM	TO	PLUGGING MATERIALS	FROM	TO	PLUGGING MATERIALS
0	1.0	Topsoil			
1.0	<del>24.50</del>	3/8 Bentonite Chips			
	<u>25.0'</u>				

**7 CONTRACTOR'S OR LANDOWNER'S CERTIFICATION:** This water well was plugged under my jurisdiction and was completed on (mo/day/year) 12/18/2019 and this record is true to the best of my knowledge and belief. Kansas Water Well Contractor's License No. 606. This Water Well Record was completed on (mo/day/year) 02/05/2020 under the business name of Dakota Technologies Company, LLC by (signature) \_\_\_\_\_

Send one white copy to Kansas Department of Health & Environment, Geology Section, 1000 SW Jackson Street, Ste. 420, Topeka, KS 66612-1367. Send one copy to WATER WELL OWNER and retain one for your records.  
 Visit us at Telephone 785-296-5524.


Correction

MW-12

**WATER WELL PLUGGING RECORD Form WWC-5P KSA 82a-1212 ID NO.**

<b>1 LOCATION OF WATER WELL:</b> County: Reno	Fraction NE ¼ NE ¼ SE ¼ SE ¼	Section Number 18	Township Number 25 T S	Range Number 9 <input type="checkbox"/> E <input type="checkbox"/> W
Street/Rural Address of Well Location; if unknown, distance & direction from nearest town or intersection: If at owner's address, check here <input type="checkbox"/> North of S.Huntsville/ W. Castleton Rd., Langdon, KS		<b>Global Positioning Systems (GPS) information:</b> Latitude: 37.871169 (in decimal degrees) Longitude: 98.344029 (in decimal degrees) Elevation: 1710 Datum: <input checked="" type="checkbox"/> WGS84, <input type="checkbox"/> NAD83, <input type="checkbox"/> NAD27 Collection Method: <input type="checkbox"/> GPS unit (Make/Model: _____) <input checked="" type="checkbox"/> Digital Map/Photo, <input type="checkbox"/> Topographic Map, <input type="checkbox"/> Land Survey Est. Accuracy: <input type="checkbox"/> < 3 m, <input checked="" type="checkbox"/> 3-5 m, <input type="checkbox"/> 5-15 m, <input type="checkbox"/> > 15 m		
<b>2 WATER WELL OWNER:</b> Enterprise Products Operating, RR#, St. Address, Box #: P.O. Box 4735 City, State ZIP Code: Houston Texas 77210				

<b>3 MARK WELL'S LOCATION WITH AN "X" IN SECTION BOX:</b>	<b>4 DEPTH OF WELL</b> <del>27.50</del> <u>25.0'</u> ft. WELL'S STATIC WATER LEVEL <u>15.98</u> ft WELL WAS USED AS: <table style="width: 100%; border: none;"> <tr> <td><input type="checkbox"/> Domestic</td> <td><input type="checkbox"/> Public Water Supply</td> <td><input type="checkbox"/> Dewatering</td> </tr> <tr> <td><input type="checkbox"/> Irrigation</td> <td><input type="checkbox"/> Oil Field Water Supply</td> <td><input checked="" type="checkbox"/> Monitoring</td> </tr> <tr> <td><input type="checkbox"/> Feedlot</td> <td><input type="checkbox"/> Domestic (Lawn &amp; Garden)</td> <td><input type="checkbox"/> Injection Well</td> </tr> <tr> <td><input type="checkbox"/> Industrial</td> <td><input type="checkbox"/> Air Conditioning</td> <td><input type="checkbox"/> Other _____</td> </tr> </table> Was a chemical/bacteriological sample submitted to Department? Yes <input type="checkbox"/> No <input checked="" type="checkbox"/>	<input type="checkbox"/> Domestic	<input type="checkbox"/> Public Water Supply	<input type="checkbox"/> Dewatering	<input type="checkbox"/> Irrigation	<input type="checkbox"/> Oil Field Water Supply	<input checked="" type="checkbox"/> Monitoring	<input 

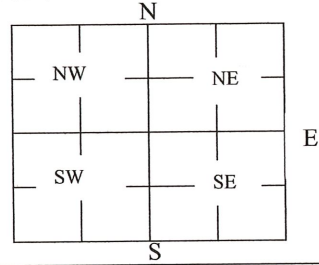

**5 TYPE OF BLANK CASING USED:**

Steel  RMP (SR)  Wrought  Fiberglass  Other (Specify below) \_\_\_\_\_  
 PVC  ABS  Asbestos-Cement  Concrete Tile \_\_\_\_\_

Blank casing diameter 2.0 in. Was casing pulled? Yes  No  If yes, how much All  
 Casing height above or below land surface 0 in.

**6 GROUT PLUG MATERIAL:**  Neat cement  Cement grout  Bentonite  Other Topsoil

Grout Plug Intervals: From 0 ft. to 1.0 ft., From 1.0 ft. to 25.0 ft., From \_\_\_\_\_ ft. to \_\_\_\_\_ ft.

What is the nearest source of possible contamination:  
 Septic tank  Seepage pit  Fuel storage  Other (specify below) Fertilized Land  
 Sewer lines  Pit privy  Fertilizer storage  
 Watertight sewer lines  Sewage lagoon  Insecticide storage  
 Lateral lines  Feedyard  Abandoned water well Direction from well? West  
 Cess pool  Livestock pens  Oil well/Gas well How many feet? 10.0

FROM	TO	PLUGGING MATERIALS	FROM	TO	PLUGGING MATERIALS
0	1.0	Topsoil			
1.0	<del>27.5</del>	3/8 Bentonite Chips			
	<u>25.0</u>				

**7 CONTRACTOR'S OR LANDOWNER'S CERTIFICATION:** This water well was plugged under my jurisdiction and was completed on (mo/day/year) 12/17/2019 and this record is true to the best of my knowledge and belief. Kansas Water Well Contractor's License No. 606. This Water Well Record was completed on (mo/day/year) 02/05/2020 under the business name of Dakota Technologies Company, LLC by (signature) \_\_\_\_\_

Send one white copy to Kansas Department of Health & Environment, Geology Section, 1000 SW Jackson Street, Ste. 420, Topeka, KS 66612-1367. Send one copy to WATER WELL OWNER and retain one for your records.  
 Visit us at Telephone 785-296-5524.


Correction

MW-13

WATER WELL PLUGGING RECORD Form WWC-5P KSA 82a-1212 ID NO.

**1 LOCATION OF WATER WELL:** Fraction NE 1/4 NE 1/4 SE 1/4 SE 1/4 Section Number 18 Township Number 25 T S Range Number 9  E  W  
 County: Reno  
 Street/Rural Address of Well Location; if unknown, distance & direction from nearest town or intersection: If at owner's address, check here  North of S.Huntsville/ W. Castleton Rd., Langdon, KS  
**Global Positioning Systems (GPS) information:**  
 Latitude: 37.871385 (in decimal degrees)  
 Longitude: 98.343949 (in decimal degrees)  
 Elevation: 1710  
 Datum:  WGS84,  NAD83,  NAD27  
 Collection Method:

**2 WATER WELL OWNER:** Enterprise Products Operating, RR#, St. Address, Box #: P.O. Box 4735 City, State ZIP Code: Houston Texas 77210  
 GPS unit (Make/Model: \_\_\_\_\_)  
 Digital Map/Photo,  Topographic Map,  Land Survey  
 Est. Accuracy:  < 3 m,  3-5 m,  5-15 m,  > 15 m

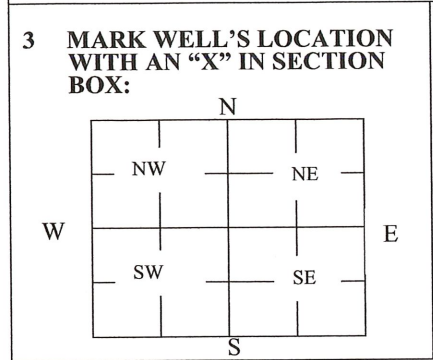

**4 DEPTH OF WELL** ~~27.0~~ **25.0'** ft.  
 WELL'S STATIC WATER LEVEL 15.85 ft  
 WELL WAS USED AS:  
 Domestic Irrigation Feedlot Industrial  
 Public Water Supply Oil Field Water Supply Domestic (Lawn & Garden) Air Conditioning  
 Dewatering Monitoring Injection Well Other \_\_\_\_\_  
 Was a chemical/bacteriological sample submitted to Department? Yes  No

**5 TYPE OF BLANK CASING USED:**  
 Steel  RMP (SR)  Wrought  Fiberglass  Other (Specify below)  
 PVC  ABS  Asbestos-Cement  Concrete Tile  
 Blank casing diameter 2.0 in. Was casing pulled? Yes  No  If yes, how much 10.0  
 Casing height above or below land surface 0 120 in.

**6 GROUT PLUG MATERIAL:**  Neat cement  Cement grout  Bentonite  Other Topsoil  
 Grout Plug Intervals: From \_\_\_\_\_ ft. to 1.0 ft., From 1.0 ft. to 25.0' ft., From \_\_\_\_\_ ft. to \_\_\_\_\_ ft.  
 What is the nearest source of possible contamination:  
 Septic tank  Seepage pit  Fuel storage  Other (specify below) Fertilized Land  
 Sewer lines  Pit privy  Fertilizer storage  
 Watertight sewer lines  Sewage lagoon  Insecticide storage  
 Lateral lines  Feedyard  Abandoned water well Direction from well? West  
 Cess pool  Livestock pens  Oil well/Gas well How many feet? 10

FROM	TO	PLUGGING MATERIALS	FROM	TO	PLUGGING MATERIALS
0	1.0	Topsoil			
1.0	<del>27.0</del>	3/8 Bentonite Chips			
	<u>25.0'</u>				

**7 CONTRACTOR'S OR LANDOWNER'S CERTIFICATION:** This water well was plugged under my jurisdiction and was completed on (mo/day/year) 12/17/2019 and this record is true to the best of my knowledge and belief. Kansas Water Well Contractor's License No. 606. This Water Well Record was completed on (mo/day/year) 02/05/2020 under the business name of Dakota Technologies Company, LLC by (signature) \_\_\_\_\_

Send one white copy to Kansas Department of Health & Environment, Geology Section, 1000 SW Jackson Street, Ste. 420, Topeka, KS 66612-1367. Send one copy to WATER WELL OWNER and retain one for your records.  
 Visit us at Telephone 785-296-5524.

Correction

MW-16

**WATER WELL PLUGGING RECORD Form WWC-5P KSA 82a-1212 ID NO.**


**1 LOCATION OF WATER WELL:** Fraction NW 1/4 NW 1/4 SW 1/4 SW 1/4 Section Number 17 Township Number 25 T S Range Number 9  E  W

Street/Rural Address of Well Location; if unknown, distance & direction from nearest town or intersection: If at owner's address, check here  North of S. Huntsville/ W. Castleton Rd., Langdon, KS

**Global Positioning Systems (GPS) information:**  
 Latitude: 37.871229 (in decimal degrees)  
 Longitude: 98.342787 (in decimal degrees)  
 Elevation: 1711  
 Datum:  WGS84,  NAD83,  NAD27  
 Collection Method:

**2 WATER WELL OWNER:** Enterprise Products Operating, RR#, St. Address, Box #: P.O. Box 4735 City, State ZIP Code: Houston Texas 77210

GPS unit (Make/Model: \_\_\_\_\_)  
 Digital Map/Photo,  Topographic Map,  Land Survey  
 Est. Accuracy:  < 3 m,  3-5 m,  5-15 m,  > 15 m

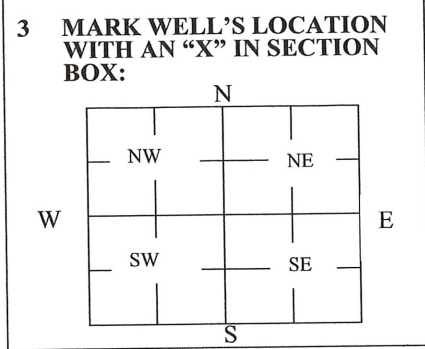

**4 DEPTH OF WELL** 25.0 ft.  
 WELL'S STATIC WATER LEVEL 13.63 ft.  
 WELL WAS USED AS:  
 Domestic  Public Water Supply  Dewatering  
 Irrigation  Oil Field Water Supply  Monitoring  
 Feedlot  Domestic (Lawn & Garden)  Injection Well  
 Industrial  Air Conditioning  Other \_\_\_\_\_  
 Was a chemical/bacteriological sample submitted to Department? Yes  No

**5 TYPE OF BLANK CASING USED:**  
 Steel  RMP (SR)  Wrought  Fiberglass  Other (Specify below)  
 PVC  ABS  Asbestos-Cement  Concrete Tile  
 Blank casing diameter 2.0 in. Was casing pulled? Yes  No  If yes, how much 13.0  
 Casing height above or below land surface ~~36.0~~ 156 in.

**6 GROUT PLUG MATERIAL:**  Neat cement  Cement grout  Bentonite  Other Topsoil  
 Grout Plug Intervals: From 0 ft. to ~~1.0~~ 25.0 ft., From 1.0 ft. to 25' ft., From \_\_\_\_\_ ft. to \_\_\_\_\_ ft.

What is the nearest source of possible contamination:  
 Septic tank  Seepage pit  Fuel storage  Other (specify below)  
 Sewer lines  Pit privy  Fertilizer storage Fertilized Land  
 Watertight sewer lines  Sewage lagoon  Insecticide storage  
 Lateral lines  Feedyard  Abandoned water well Direction from well? South  
 Cess pool  Livestock pens  Oil well/Gas well How many feet? 75

FROM	TO	PLUGGING MATERIALS	FROM	TO	PLUGGING MATERIALS
0	1.0	Topsoil			
1.0	25.0	3/8 Bentonite Chips			

**7 CONTRACTOR'S OR LANDOWNER'S CERTIFICATION:** This water well was plugged under my jurisdiction and was completed on (mo/day/year) 12/17/2019 and this record is true to the best of my knowledge and belief. Kansas Water Well Contractor's License No. 606. This Water Well Record was completed on (mo/day/year) 02/05/2020 under the business name of Dakota Technologies Company, LLC by (signature) \_\_\_\_\_



CORRECTION

MW-17


**WATER WELL PLUGGING RECORD Form WWC-5P KSA 82a-1212 ID NO.**

<b>1 LOCATION OF WATER WELL:</b> County: <b>Reno</b>	Fraction <b>SW 1/4 NW 1/4 SW 1/4 SW 1/4</b>	Section Number <b>17</b>	Township Number <b>25 T S</b>	Range Number <b>9</b> <input type="checkbox"/> E <input type="checkbox"/> W
---	--	-----------------------------	----------------------------------	--

Street/Rural Address of Well Location; if unknown, distance & direction from nearest town or intersection: If at owner's address, check here  North of S.Huntsville/ W. Castleton Rd., Langdon, KS

**Global Positioning Systems (GPS) information:**  
 Latitude: **37.870700** (in decimal degrees)  
 Longitude: **98.342988** (in decimal degrees)  
 Elevation: **1711**  
 Datum:  WGS84,  NAD83,  NAD27  
 Collection Method:  
 GPS unit (Make/Model: \_\_\_\_\_)  
 Digital Map/Photo,  Topographic Map,  Land Survey  
 Est. Accuracy:  < 3 m,  3-5 m,  5-15 m,  > 15 m

**2 WATER WELL OWNER:** Enterprise Products Operating, RR#, St. Address, Box #: P.O. Box 4735  
 City, State ZIP Code: Houston Texas 77210

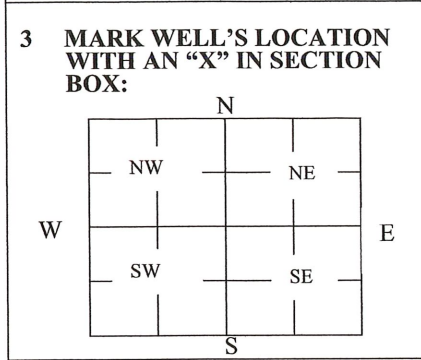

**4 DEPTH OF WELL** 23.0 ft.  
 WELL'S STATIC WATER LEVEL 14.26 ft  
 WELL WAS USED AS:  
 Domestic Irrigation Feedlot Industrial  
 Public Water Supply Oil Field Water Supply Domestic (Lawn & Garden) Air Conditioning  
 Dewatering Monitoring Injection Well Other \_\_\_\_\_  
 Was a chemical/bacteriological sample submitted to Department? Yes  No

**5 TYPE OF BLANK CASING USED:**

Steel  RMP (SR)  Wrought  Fiberglass  Other (Specify below)  
 PVC  ABS  Asbestos-Cement  Concrete Tile

Blank casing diameter 2.0 in. Was casing pulled? Yes  No  If yes, how much All  
 Casing height above or below land surface 36.0 in.

**6 GROUT PLUG MATERIAL:**  Neat cement  Cement grout  Bentonite  Other Topsoil

Grout Plug Intervals: From 0 ft. to 23.0 ft., From 1.0 ft. to 23.0 ft., From \_\_\_\_\_ ft. to \_\_\_\_\_ ft.

What is the nearest source of possible contamination:  
 Septic tank  Seepage pit  Fuel storage  Other (specify below)  
 Sewer lines  Pit privy  Fertilizer storage Fertilized Land  
 Watertight sewer lines  Sewage lagoon  Insecticide storage  
 Lateral lines  Feedyard  Abandoned water well  
 Cess pool  Livestock pens  Oil well/Gas well  
 Direction from well? North  
 How many feet? 25

FROM	TO	PLUGGING MATERIALS	FROM	TO	PLUGGING MATERIALS
0	1.0	Topsoil			
1.0	23.0	3/8 Bentonite Chips			

**7 CONTRACTOR'S OR LANDOWNER'S CERTIFICATION:** This water well was plugged under my jurisdiction and was completed on (mo/day/year) 12/17/2019 and this record is true to the best of my knowledge and belief. Kansas Water Well Contractor's License No. 606. This Water Well Record was completed on (mo/day/year) 02/05/2020 under the business name of Dakota Technologies Company, LLC by (signature) \_\_\_\_\_


Send one white copy to Kansas Department of Health & Environment, Geology Section, 1000 SW Jackson Street, Ste. 420, Topeka, KS 66612-1367. Send one copy to WATER WELL OWNER and retain one for your records.  
 Visit us at \_\_\_\_\_ Telephone 785-296-5524.

Correction

WATER WELL PLUGGING RECORD Form WWC-5P KSA 82a-1212 ID NO.

**1 LOCATION OF WATER WELL:** Fraction NW 1/4 NW 1/4 SW 1/4 SW 1/4 Section Number 17 Township Number 25 T S Range Number 9  E  W  
 County: Reno  
 Street/Rural Address of Well Location; if unknown, distance & direction from nearest town or intersection: If at owner's address, check here  North of S.Huntsville/ W. Castleton Rd., Langdon, KS  
**Global Positioning Systems (GPS) information:**  
 Latitude: 37.870955 (in decimal degrees)  
 Longitude: 98.342401 (in decimal degrees)  
 Elevation: 1710  
 Datum:  WGS84,  NAD83,  NAD27  
 Collection Method:

**2 WATER WELL OWNER:** Enterprise Products Operating, RR#, St. Address, Box #: P.O. Box 4735 City, State ZIP Code: Houston Texas 77210  
 GPS unit (Make/Model: \_\_\_\_\_)  
 Digital Map/Photo,  Topographic Map,  Land Survey  
 Est. Accuracy:  < 3 m,  3-5 m,  5-15 m,  > 15 m

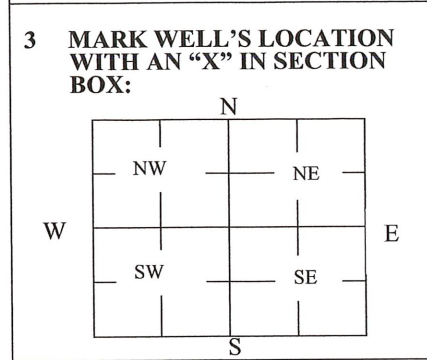

**4 DEPTH OF WELL** 23.0 ft.  
 WELL'S STATIC WATER LEVEL 13.16 ft  
 WELL WAS USED AS:  
 Domestic  Public Water Supply  Dewatering  
 Irrigation  Oil Field Water Supply  Monitoring  
 Feedlot  Domestic (Lawn & Garden)  Injection Well  
 Industrial  Air Conditioning  Other \_\_\_\_\_  
 Was a chemical/bacteriological sample submitted to Department? Yes  No

**5 TYPE OF BLANK CASING USED:**  
 Steel  RMP (SR)  Wrought  Fiberglass  Other (Specify below)  
 PVC  ABS  Asbestos-Cement  Concrete Tile  
 Blank casing diameter 2.0 in. Was casing pulled? Yes  No  If yes, how much All  
 Casing height above or below land surface 36.0 in.

**6 GROUT PLUG MATERIAL:**  Neat cement  Cement grout  Bentonite  Other Topsoil  
 Grout Plug Intervals: From 0 ft. to 1.0 ft., From 1.0' ft. to 23.0' ft., From \_\_\_\_\_ ft. to \_\_\_\_\_ ft.  
 What is the nearest source of possible contamination:  
 Septic tank  Seepage pit  Fuel storage  Other (specify below) Fertilized Land  
 Sewer lines  Pit privy  Fertilizer storage  
 Watertight sewer lines  Sewage lagoon  Insecticide storage  
 Lateral lines  Feedyard  Abandoned water well Direction from well? South  
 Cess pool  Livestock pens  Oil well/Gas well How many feet? 50

FROM	TO	PLUGGING MATERIALS	FROM	TO	PLUGGING MATERIALS
0	1.0	Topsoil			
1.0	23.0	3/8 Bentonite Chips			

**7 CONTRACTOR'S OR LANDOWNER'S CERTIFICATION:** This water well was plugged under my jurisdiction and was completed on (mo/day/year) 12/17/2019 and this record is true to the best of my knowledge and belief. Kansas Water Well Contractor's License No. 606. This Water Well Record was completed on (mo/day/year) 02/05/2020 under the business name of Dakota Technologies Company, LLC by (signature)

Send one white copy to Kansas Department of Health & Environment, Geology Section, 1000 SW Jackson Street, Ste. 420, Topeka, KS 66612-1367. Send one copy to WATER WELL OWNER and retain one for your records.  
 Visit us at Telephone 785-296-5524.