

Correction

MW-09

WATER WELL PLUGGING RECORD Form WWC-5P KSA 82a-1212 ID NO.


1 LOCATION OF WATER WELL: Fraction NE 1/4 NE 1/4 SE 1/4 SE 1/4 Section Number 18 Township Number 25 T S Range Number 9 E W
 County: Reno

Street/Rural Address of Well Location; if unknown, distance & direction from nearest town or intersection: If at owner's address, check here North of S. Huntsville/ W. Castleton Rd., Langdon, KS

Global Positioning Systems (GPS) information:
 Latitude: 37.871424 (in decimal degrees)
 Longitude: 98.343662 (in decimal degrees)
 Elevation: 1709
 Datum: WGS84, NAD83, NAD27
 Collection Method:

2 WATER WELL OWNER: Enterprise Products Operating, RR#, St. Address, Box #: P.O. Box 4735
 City, State ZIP Code: Houston Texas 77210

GPS unit (Make/Model: _____)
 Digital Map/Photo, Topographic Map, Land Survey
 Est. Accuracy: < 3 m, 3-5 m, 5-15 m, > 15 m

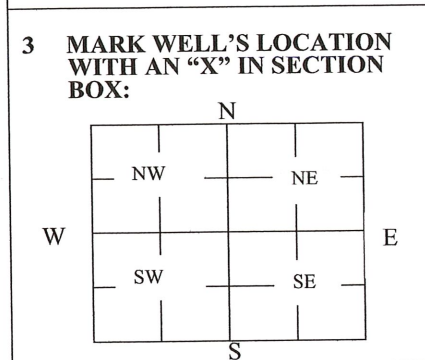

4 DEPTH OF WELL ~~19.0~~ 25.0' ft.
 WELL'S STATIC WATER LEVEL 13.69 ft
 WELL WAS USED AS:

Domestic Public Water Supply Dewatering
 Irrigation Oil Field Water Supply Monitoring
 Feedlot Domestic (Lawn & Garden) Injection Well
 Industrial Air Conditioning Other _____

Was a chemical/bacteriological sample submitted to Department? Yes No

5 TYPE OF BLANK CASING USED:

Steel RMP (SR) Wrought Fiberglass Other (Specify below) _____
 PVC ABS Asbestos-Cement Concrete Tile _____

Blank casing diameter 2.0 in. Was casing pulled? Yes No If yes, how much All
 Casing height above or below land surface 0 in.

6 GROUT PLUG MATERIAL: Neat cement Cement grout Bentonite Other Topsoil

Grout Plug Intervals: From 0 ft. to ~~19.0~~ 1.0 ft., From 1.0 ft. to 25.0 ft., From _____ ft. to _____ ft.

What is the nearest source of possible contamination:

Septic tank Seepage pit Fuel storage Other (specify below) Fertilized Land
 Sewer lines Pit privy Fertilizer storage
 Watertight sewer lines Sewage lagoon Insecticide storage
 Lateral lines Feedyard Abandoned water well Direction from well? West
 Cess pool Livestock pens Oil well/Gas well How many feet? 30.0

FROM	TO	PLUGGING MATERIALS	FROM	TO	PLUGGING MATERIALS
0	1.0	Topsoil			
1.0	19.0	3/8 Bentonite Chips			
	<u>25.0'</u>				

7 CONTRACTOR'S OR LANDOWNER'S CERTIFICATION: This water well was plugged under my jurisdiction and was completed on (mo/day/year) 12/18/2019 and this record is true to the best of my knowledge and belief. Kansas Water Well Contractor's License No. 606. This Water Well Record was completed on (mo/day/year) 02/05/2020 under the business name of Dakota Technologies Company, LLC by (signature) _____

Send one white copy to Kansas Department of Health & Environment, Geology Section, 1000 SW Jackson Street, Ste. 420, Topeka, KS 66612-1367. Send one copy to WATER WELL OWNER and retain one for your records.
 Visit us at _____ Telephone 785-296-5524.