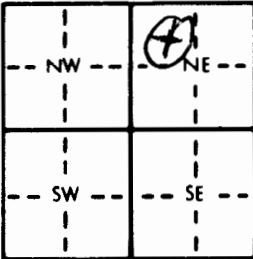
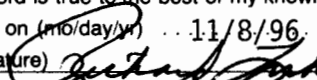


1 LOCATION OF WATER WELL: County: SEDGWICK		Fraction SE 1/4 NW 1/4 NE 1/4		Section Number 19	Township Number T 26 S	Range Number R 1 E
Distance and direction from nearest town or city street address of well if located within city? 4321' N, 1543' W FROM SE CORNER OF SECTION 19					AIR SPARGE WELL 003	
2 WATER WELL OWNER: MR. CLIFF CALLAGHAN RR#, St. Address, Box #: 3840 S. 135TH STREET WEST City, State, ZIP Code: WICHITA, KANSAS 67215		Board of Agriculture, Division of Water Resources Application Number:				
3 LOCATE WELL'S LOCATION WITH AN "X" IN SECTION BOX: 		4 DEPTH OF COMPLETED WELL: 30.0 ft. ELEVATION: NA Depth(s) Groundwater Encountered 1. 15.0 ft. 2. ft. 3. ft. WELL'S STATIC WATER LEVEL N/A ft. below land surface measured on mo/day/yr Pump test data: Well water was ft. after hours pumping gpm Est. Yield gpm: Well water was ft. after hours pumping gpm Bore Hole Diameter in. to ft., and in. to ft. WELL WATER TO BE USED AS: 5 Public water supply 8 Air conditioning 11 Injection well 1 Domestic 3 Feedlot 6 Oil field water supply 9 Dewatering 12 Other (Specify below) AIR SPARGE 2 Irrigation 4 Industrial 7 Lawn and garden only 10 Monitoring well Was a chemical/bacteriological sample submitted to Department? Yes No; If yes, mo/day/yr sample was submitted Water Well Disinfected? Yes No				
5 TYPE OF BLANK CASING USED: 1 Steel 3 RMP (SR) 5 Wrought iron 8 Concrete tile CASING JOINTS: Glued Clamped 2 PVC 4 ABS 6 Asbestos-Cement 9 Other (specify below) Welded Blank casing diameter 2.0 in. to 28.0 ft., Dia. in. to ft., Dia. in. to ft. Casing height above land surface 0 in., weight 0.93 lbs./ft. Wall thickness or gauge No. SCH 80 TYPE OF SCREEN OR PERFORATION MATERIAL: 1 Steel 2 Stainless steel 5 Fiberglass 7 PVC 10 Asbestos-cement 2 Brass 4 Galvanized steel 6 Concrete tile 8 RMP (SR) 11 Other (specify) SCREEN OR PERFORATION OPENINGS ARE: 1 Continuous slot 3 Mill slot 5 Gauzed wrapped 8 Saw cut 11 None (open hole) 2 Louvered shutter 4 Key punched 6 Wire wrapped 9 Drilled holes SCREEN-PERFORATED INTERVALS: From 28.0 ft. to 30.0 ft., From ft. to ft. GRAVEL PACK INTERVALS: From 25.5 ft. to 30.0 ft., From ft. to ft. 6 GROUT MATERIAL: 1 Neat cement 2 Cement grout 3 Bentonite 4 Other XXXX CEMENT/BENTONITE Grout Intervals: From 2.0 ft. to 25.5 ft., From ft. to ft., From ft. to ft. What is the nearest source of possible contamination: 1 Septic tank 4 Lateral lines 7 Pit privy 10 Livestock pens 14 Abandoned water well 2 Sewer lines 5 Cess pool 8 Sewage lagoon 11 Fuel storage 15 Oil well/Gas well 3 Watertight sewer lines 6 Seepage pit 9 Feedyard 12 Fertilizer storage 16 Other (specify below) Direction from well? IN BASIN How many feet? 0 12 Other (Specify below) FORMER LUST						
7 CONTRACTOR'S OR LANDOWNER'S CERTIFICATION: This water well was (1) constructed, (2) reconstructed, or (3) plugged under my jurisdiction and was completed on (mo/day/year) 6/17/96 and this record is true to the best of my knowledge and belief. Kansas Water Well Contractor's License No. 524 This Water Well Record was completed on (mo/day/yr) 11/8/96 under the business name of ALLIED LABORATORIES by (signature) 						
INSTRUCTIONS: Use typewriter or ball point pen. PLEASE PRESS FIRMLY and PRINT clearly. Please fill in blanks, underline or circle the correct answers. Send top three copies to Kansas Department of Health and Environment, Bureau of Water, Topeka, Kansas 66620-0001. Telephone: 913-296-5545. Send one to WATER WELL OWNER and retain one for your records.						