

SE NW SW SE

WATER WELL RECORD Form WWC-5 KSA 82a-1212

1 LOCATION OF WATER WELL: Fraction ~~1/4~~ ~~1/4~~ ~~1/4~~ Section Number 19 Township Number T 26 S Range Number R 1 E W

County: Sedgwick


Distance and direction from nearest town or city street address of well if located within city?

See below

2 WATER WELL OWNER: Don McKenzie  
 RR#, St. Address, Box #: 731 Surrey Lane  
 City, State, ZIP Code: Maize, KS 67101

Board of Agriculture, Division of Water Resources  
 Application Number:

3 LOCATE WELL'S LOCATION WITH AN "X" IN SECTION BOX:

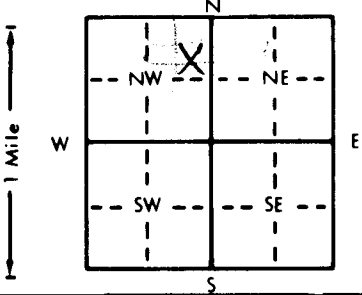

4 DEPTH OF COMPLETED WELL 57 ft. ELEVATION:

Depth(s) Groundwater Encountered 1 15 ft. 2 . ft. 3 . ft.

WELL'S STATIC WATER LEVEL 15 ft. below land surface measured on mo/day/yr 3-6-97

Pump test data: Well water was . ft. after . hours pumping . gpm

Est. Yield 17 gpm: Well water was . ft. after . hours pumping . gpm

Bore Hole Diameter 11 in. to 57 ft., and . in. to . ft.

WELL WATER TO BE USED AS: 5 Public water supply 8 Air conditioning 11 Injection well

1 Domestic 3 Feedlot 6 Oil field water supply 9 Dewatering 12 Other (Specify below)

2 Irrigation 4 Industrial 7 Lawn and garden only 10 Monitoring well

Was a chemical/bacteriological sample submitted to Department? Yes . No X; If yes, mo/day/yr sample was submitted

Water Well Disinfected? Yes X No

5 TYPE OF BLANK CASING USED: 5 Wrought iron 8 Concrete tile CASING JOINTS: Glued X Clamped .

1 Steel 3 RMP (SR) 6 Asbestos-Cement 9 Other (specify below) Welded .

2 PVC 4 ABS 7 Fiberglass . Threaded .

Blank casing diameter 5 in. to 47 ft., Dia . in. to . ft., Dia . in. to . ft.

Casing height above land surface 12 in., weight 2.40 lbs./ft. Wall thickness or gauge No. 16.0 RSE

TYPE OF SCREEN OR PERFORATION MATERIAL: 7 PVC 10 Asbestos-cement

1 Steel 3 Stainless steel 5 Fiberglass 8 RMP (SR) 11 Other (specify) .

2 Brass 4 Galvanized steel 6 Concrete tile 9 ABS 12 None used (open hole)

SCREEN OR PERFORATION OPENINGS ARE: 5 Gauzed wrapped 8 Saw cut 11 None (open hole)

1 Continuous slot 3 Mill slot 6 Wire wrapped 9 Drilled holes

2 Louvered shutter 4 Key punched 7 Torch cut 10 Other (specify) .

SCREEN-PERFORATED INTERVALS: From 47 ft. to 57 ft., From . ft. to . ft.

From . ft. to . ft., From . ft. to . ft.

GRAVEL PACK INTERVALS: From 15 ft. to 57 ft., From . ft. to . ft.

From . ft. to . ft., From . ft. to . ft.

6 GROUT MATERIAL: 3 Neat cement 15 Cement grout 3 Bentonite 4 Other .

Grout Intervals: From . ft. to . ft., From . ft. to . ft., From . ft. to . ft.

What is the nearest source of possible contamination:

1 Septic tank 4 Lateral lines 7 Pit privy 10 Livestock pens 14 Abandoned water well

2 Sewer lines 5 Cess pool 8 Sewage lagoon 11 Fuel storage 15 Oil well/Gas well

3 Watertight sewer lines 6 Seepage pit 9 Feedyard 12 Fertilizer storage 16 Other (specify below)

13 Insecticide storage

Direction from well? West How many feet? 60

| FROM | TO | LITHOLOGIC LOG | FROM | TO | PLUGGING INTERVALS |
|------|----|----------------|------|----|--------------------|
| 0    | 22 | clay           |      |    |                    |
| 22   | 38 | fine sand      |      |    |                    |
| 38   | 40 | clay           |      |    |                    |
| 40   | 57 | gravel         |      |    |                    |

7 CONTRACTOR'S OR LANDOWNER'S CERTIFICATION: This water well was (1) constructed, (2) reconstructed, or (3) plugged under my jurisdiction and was completed on (mo/day/year) 3-7-97 and this record is true to the best of my knowledge and belief. Kansas Water Well Contractor's License No. 318 This Water Well Record was completed on (mo/day/yr) 3-10-97 under the business name of Weninger Drilling Inc. by (signature) Michele Becker

INSTRUCTIONS: Use typewriter or ball point pen. PLEASE PRESS FIRMLY and PRINT clearly. Please fill in blanks, underline or circle the correct answers. Send top three copies to Kansas Department of Health and Environment, Bureau of Water, Topeka, Kansas 66620-0001. Telephone: 913-296-5545. Send one to WATER WELL OWNER and retain one for your records.