

1 LOCATION OF WATER WELL: Fraction NW 1/4 SE 1/4 NW 1/4 Section Number 25 Township Number T 26 S Range Number R 1 EW

Distance and direction from nearest town or city street address of well if located within city?

4100 N. West St.

2 WATER WELL OWNER:

RR#, St. Address, Box # :

City, State, ZIP Code :

City of Wichita


1900 E 9th St.

Wichita KS 67214

Board of Agriculture, Division of Water Resources

Application Number:

3 LOCATE WELL'S LOCATION WITH AN "X" IN SECTION BOX:

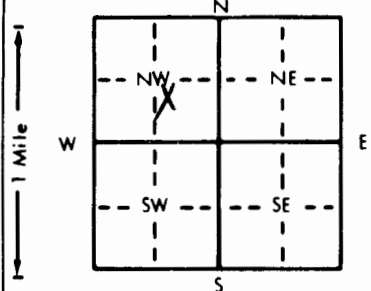

4 DEPTH OF COMPLETED WELL 54 ft. ELEVATION:

Depth(s) Groundwater Encountered 1. 15 ft. 2. ft. 3. ft.

WELL'S STATIC WATER LEVEL ft. below land surface measured on mo/day/yr

Pump test data: Well water was ft. after hours pumping gpm

Est. Yield gpm: Well water was ft. after hours pumping gpm

Bore Hole Diameter 8 in. to 54 ft., and in. to ft.

WELL WATER TO BE USED AS: 5 Public water supply 8 Air conditioning 11 Injection well

1 Domestic 3 Feedlot 6 Oil field water supply 9 Dewatering 12 Other (Specify below)

2 Irrigation 4 Industrial 7 Lawn and garden only 10 Monitoring well Spargel

Was a chemical/bacteriological sample submitted to Department? Yes No X; If yes, mo/day/yr sample was submitted Water Well Disinfected? Yes No X

5 TYPE OF BLANK CASING USED:

1 Steel 3 RMP (SR)

2 PVC 4 ABS

Blank casing diameter 2 in. to 52 ft. Dia

Casing height above land surface 0 in. weight

TYPE OF SCREEN OR PERFORATION MATERIAL:

1 Steel 3 Stainless steel 5 Fiberglass

2 Brass 4 Galvanized steel 6 Concrete tile

SCREEN OR PERFORATION OPENINGS ARE:

1 Continuous slot 3 Mill slot

2 Louvered shutter 4 Key punched

SCREEN-PERFORATED INTERVALS: From 52 ft. to 54 ft.

GRAVEL PACK INTERVALS: From 50 ft. to 54 ft.

From ft. to ft. From ft. to ft.

From ft. to ft. From ft. to ft.

6 GROUT MATERIAL:

Grout Intervals: From 0 ft. to 3 ft.

What is the nearest source of possible contamination:

1 Septic tank 4 Lateral lines 7 Pit privy

2 Sewer lines 5 Cess pool 8 Sewage lagoon

3 Watertight sewer lines 6 Seepage pit 9 Feedyard

Direction from well?

FROM TO LITHOLOGIC LOG

0 13 Silty Clay

13 56 Sand

56 Shale

FROM TO

FROM TO

7 CONTRACTOR'S OR LANDOWNER'S CERTIFICATION: This water well was (1) constructed, (2) reconstructed, or (3) plugged under my jurisdiction and was completed on (mo/day/year) 11/21/97 and this record is true to the best of my knowledge and belief. Kansas

Water Well Contractor's License No. 531 This Water Well Record was completed on (mo/day/yr) 12/10/97

under the business name of GSI by (signature) Allison M. Ivins

INSTRUCTIONS: Use typewriter or ball point pen. PLEASE PRESS FIRMLY and PRINT clearly. Please fill in blanks, underline or circle the correct answers. Send top three copies to Kansas Department of Health and Environment, Bureau of Water, Topeka, Kansas 66620-0001. Telephone: 913-296-5545. Send one to WATER WELL OWNER and retain one for your records.

OFFICE USE ONLY

T

R

EW

SEC.

1/4

1/4

1/4