


1 LOCATION OF WATER WELL: County: Sedgwick Fraction: NW 1/4 SE 1/4 NW 1/4 Section Number: 25 Township Number: T 26 S Range Number: R 1 EW
 Distance and direction from nearest town or city street address of well if located within city?
4100 N West St.

2 WATER WELL OWNER: RR#, St. Address, Box #: City of Wichita 1900 E 9th St. Board of Agriculture, Division of Water Resources
 City, State, ZIP Code: Wichita KS 67214 Application Number:

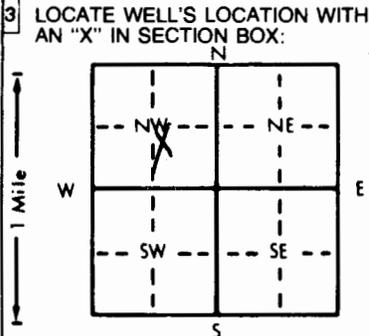

4 DEPTH OF COMPLETED WELL: 50 ft. ELEVATION:
 Depth(s) Groundwater Encountered 1. 15 ft. 2. ft. 3. ft.
 WELL'S STATIC WATER LEVEL: ft. below land surface measured on mo/day/yr
 Pump test data: Well water was ft. after hours pumping gpm
 Est. Yield gpm: Well water was ft. after hours pumping gpm
 Bore Hole Diameter: 8 in. to 50 ft., and in. to ft.
 WELL WATER TO BE USED AS:
 1 Domestic 3 Feedlot 6 Oil field water supply 9 Dewatering 12 Other (Specify below)
 2 Irrigation 4 Industrial 7 Lawn and garden only 10 Monitoring well Storage
 Was a chemical/bacteriological sample submitted to Department? Yes No X; If yes, mo/day/yr sample was submitted
 Water Well Disinfected? Yes No X

5 TYPE OF BLANK CASING USED:
 1 Steel 3 RMP (SR) 5 Wrought iron 8 Concrete tile CASING JOINTS: Glued Clamped
2 PVC 4 ABS 6 Asbestos-Cement 9 Other (specify below) Welded
 7 Fiberglass Threaded Flush
 Blank casing diameter: 2 in. to 48 ft., Dia. in. to ft., Dia. in. to ft.
 Casing height above land surface: 0 in., weight lbs./ft. Wall thickness or gauge No. Sch 40
 TYPE OF SCREEN OR PERFORATION MATERIAL:
 1 Steel 3 Stainless steel 5 Fiberglass PVC 10 Asbestos-cement
 2 Brass 4 Galvanized steel 6 Concrete tile 8 RMP (SR) 11 Other (specify)
 12 None used (open hole)
 SCREEN OR PERFORATION OPENINGS ARE:
 1 Continuous slot 4 Mill slot 5 Gauzed wrapped 8 Saw cut 11 None (open hole)
 2 Louvered shutter 4 Key punched 6 Wire wrapped 9 Drilled holes
 7 Torch cut 10 Other (specify)
 SCREEN-PERFORATED INTERVALS: From 48 ft. to 50 ft., From ft. to ft.
 GRAVEL PACK INTERVALS: From 46 ft. to 50 ft., From ft. to ft.

6 GROUT MATERIAL: 1 Neat cement 2 Cement grout 3 Bentonite 4 Other
 Grout Intervals: From 0 ft. to 3 ft., From 3 ft. to 40 ft., From ft. to ft.
 What is the nearest source of possible contamination:
 1 Septic tank 4 Lateral lines 7 Pit privy 10 Livestock pens 14 Abandoned water well
 2 Sewer lines 5 Cess pool 8 Sewage lagoon 11 Fuel storage 15 Oil well/Gas well
 3 Watertight sewer lines 6 Seepage pit 9 Feedyard 12 Fertilizer storage 16 Other (specify below)
 13 Insecticide storage
 Direction from well? How many feet?

FROM	TO	LITHOLOGIC LOG	FROM	TO	PLUGGING INTERVALS
0	13	Silty Clay			
13	53	Sand			
53		Shale			

7 CONTRACTOR'S OR LANDOWNER'S CERTIFICATION: This water well was (1) constructed (2) reconstructed, or (3) plugged under my jurisdiction and was completed on (mo/day/year) 11/21/97 and this record is true to the best of my knowledge and belief. Kansas
 Water Well Contractor's License No. 531 This Water Well Record was completed on (mo/day/yr) 12/10/97
 under the business name of GSI by (signature) Alison M. Swain

OFFICE USE ONLY T R EW SEC 1/4 1/4 1/4