


1 LOCATION OF WATER WELL: <b>Sedgwick</b>	FRACTION <b>NE 1/4 SE 1/4 SW 1/4</b>	Section Number <b>34</b>	Township Number <b>T 26 S</b>	Range Number <b>R 1W E/W</b>
--	---	-----------------------------	----------------------------------	---------------------------------

Distance and direction from nearest town or city street address of well if located within city?  
**29th St. North and Ridge Road Wichita, Kansas**

WATER WELL OWNER: **WICHITA, CITY OF**  
 RR#, ST. ADDRESS, BOX #: **455 N. Main**  
 CITY, STATE, ZIP CODE: **Wichita, Kansas 67202**  
 Board of Agriculture, Division of Water Resource  
 Application Number: **980242**

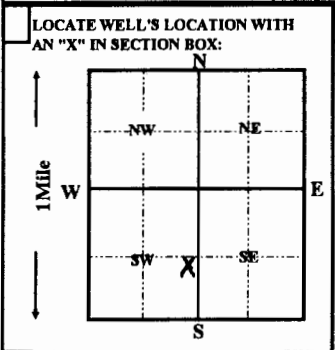

4 DEPTH OF ~~CONCRETE~~ WELL **50** ft. ELEVATION:

Depth(s) groundwater Encountered **1** ft. **2** ft. **3** ft. ft.

WELL'S STATIC WATER LEVEL **6** FT. BELOW LAND SURFACE MEASURED ON **06/12/1999** mo/day/yr

Pump test data: Well water was \_\_\_\_\_ ft. after \_\_\_\_\_ hours pumping \_\_\_\_\_ gpm

Est. Yield \_\_\_\_\_ gpm: Well water was \_\_\_\_\_ ft. after \_\_\_\_\_ hours pumping \_\_\_\_\_ gpm

Bore Hole Diameter \_\_\_\_\_ in. to \_\_\_\_\_ ft. and \_\_\_\_\_ in. to \_\_\_\_\_ ft.

WELL WATER TO BE USED AS:

<b>5</b> Public water supply	<b>8</b> Air conditioning	<b>11</b> Injection well
<b>1</b> Domestic	<b>3</b> Feedlot	<b>6</b> Oil field water supply
<b>2</b> Irrigation	<b>4</b> Industrial	<b>7</b> Lawn and garden only
<b>6</b> Oil field water supply	<b>9</b> Dewatering	<b>12</b> Other (Specify below)
<b>7</b> Lawn and garden only	<b>10</b> Monitoring well	

Was a chemical/bacteriological sample submitted to Department? Yes \_\_\_\_\_ No **X** ; If yes, mo/day/yr sample was submitted \_\_\_\_\_

Water Well Disinfected? Yes **X** No \_\_\_\_\_

5 TYPE OF CASING USED:

1 Steel	3 RMP (SR)	5 Wrought iron	8 Concrete tile	CASING JOINTS:	Glued	Clamped
2 PVC	4 ABS	6 Asbestos-Cement	9 Other (Specify below)		Welded	
		7 Fiberglass			Threaded	

Blank casing Diameter **8** in. to \_\_\_\_\_ ft., Dia \_\_\_\_\_ in. to \_\_\_\_\_ ft.

Casing height above land surface **36** in., weight \_\_\_\_\_ lbs. / ft. Wall thickness or gauge No. \_\_\_\_\_

TYPE OF SCREEN OR PERFORATION MATERIAL:

1 Steel	3 Stainless Steel	5 Fiberglass	8 RMP (SR)	11 other (specify)	<b>N/A</b>
2 Brass	4 Galvanized steel	6 Concrete tile	9 ABS	12 None used (open hole)	

SCREEN OR PERFORATION OPENING ARE:

1 Continuous slot	3 Mill slot	5 Gauzed wrapped	8 Saw cut	11 None (open hole)
2 Louvered shutter	4 Key punched	6 Wire wrapped	9 Drilled holes	
		7 Torch cut	10 Other (specify)	<b>N/A</b>

SCREEN-PERFORATION INTERVALS: from \_\_\_\_\_ ft. to \_\_\_\_\_ ft., From \_\_\_\_\_ ft. to \_\_\_\_\_ ft.

GRAVEL PACK INTERVALS: from \_\_\_\_\_ ft. to \_\_\_\_\_ ft., From \_\_\_\_\_ ft. to \_\_\_\_\_ ft.

6 GROUT MATERIAL: 1 Neat cement 2 Cement grout 3 Bentonite 4 Other **bentonite hole plug**

Grout Intervals: From **3** ft. to **8** ft. From \_\_\_\_\_ ft. to \_\_\_\_\_ ft.

What is the nearest source of possible contamination:

1 Septic tank	4 Lateral lines	7 Pit privy	10 Livestock pens	14 Abandon water well
2 Sewer lines	5 Cess pool	8 Sewage lagoon	11 Fuel storage	15 Oil well/Gas well
3 Watertight sewer lines	6 Seepage pit	9 Feedyard	12 Fertilizer storage	16 Other (specify below)
			13 Insecticide storage	<b>None Apparent</b>

Direction from well? \_\_\_\_\_ How many feet? \_\_\_\_\_

FROM	TO	LITHOLOGIC LOG	FROM	TO	PLUGGING INTERVALS
			0	3	surface sand and silt
			3	8	cement grout
			8	15	bentonite hole plug
			15	50	chlorinated sand and gravel

7 CONTRACTOR'S OR LANDOWNER'S CERTIFICATION: This water well was (1) constructed, (2) reconstructed, or (3) plugged under my jurisdiction and was completed on (mo/day/year) **06/12/1999** and this record is true to the best of my knowledge and belief. Kansas Water Well Contractor's License No. **236** This Water Well Record was completed on (mo/day/yr) **06/14/99**  
 Under the business name of **Harp Well & Pump Service, Inc.** by (signature) **Todd S. Harp**