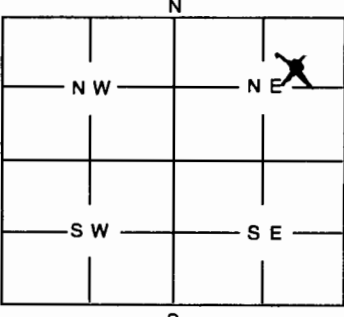


1	LOCATION OF WATER WELL: County: Sedgwick	Fraction NW SW SE NW near center NE	Section Number 24	Township Number 26	Range Number 1 W
---	--	---	-----------------------------	------------------------------	----------------------------

Distance and direction from nearest town or city street address of well if located within city?

In city limits, 3515 Bayview Court, Wichita, KS

2	WATER WELL OWNER: Mr. Shea; c/o Fahnestock Htg. & Cooling	Board of Agriculture, Division of Water Resources
	RR #, St. Address, Box #: 3532 Comotara	Application Number:
	City, State, ZIP Code: Wichita, KS 67226-9883	

		WELL WAS USED AS: <table border="0"> <tr> <td>1 Domestic</td> <td>5 Public Water Supply</td> <td>9 Dewatering</td> </tr> <tr> <td>2 Irrigation</td> <td>6 Oil Field Water Supply</td> <td>10 Monitoring Well</td> </tr> <tr> <td>3 Feedlot</td> <td>7 Domestic (Lawn & Garden)</td> <td>11 Injection Well</td> </tr> <tr> <td>4 Industrial</td> <td>8 Air Conditioning</td> <td>12 Other Heat Pump</td> </tr> </table> Was a chemical / bacteriological sample submitted to Department? Yes No X..... If yes, mo/day/yr sample was submitted Water Well Disinfected: Yes No X.....		1 Domestic	5 Public Water Supply	9 Dewatering	2 Irrigation	6 Oil Field Water Supply	10 Monitoring Well	3 Feedlot	7 Domestic (Lawn & Garden)	11 Injection Well	4 Industrial	8 Air Conditioning	12 Other Heat Pump

5	TYPE OF BLANK CASING USED:
	1 Steel 3 RMP (SR) 5 Wrought 7 Fiberglass XX Other (Specify below) 2 PVC 4 ABS 6 Asbestos-Cement 8 Concrete Tile Polyethylene
	Blank casing diameter 3/4 in. Was casing pulled? Yes No If yes, how much
	Casing height above or below land surface

6	GROUT PLUG MATERIAL: 1 Neat cement 2 Cement grout X Bentonite 4 Other
	Grout Plug Intervals: From 0 ft. to 200 ft., From 0 ft. to 200 ft., From 0 to 200 ft.
	What is the nearest source of possible contamination?
	1 Septic tank 6 Seepage pit 11 Fuel storage 16 Other (specify below) 2 Sewer lines 7 Pit privy 12 Fertilizer storage 3 Watertight sewer lines 8 Sewage lagoon 13 Insecticide storage 4 Lateral lines 9 Feedyard 14 Abandoned water well 5 Cess Pool 10 Livestock pens 15 Oil well/Gas well
	Direction from well? NORTH How many feet? 30 - 100 ft.

FROM	TO	PLUGGING MATERIALS

7	CONTRACTOR'S OR LANDOWNER'S CERTIFICATION: This water well was plugged under my jurisdiction and was completed on (mo/day/year) 01/24/02 and this record is true to the best of my knowledge and belief. Kansas Water Well Contractor's License No. 138 This Water Well Record was completed on (mo/day/year) 1/24/02 under the business name of Peterson Irrigation, Inc. by (signature) <i>Mike Peterson</i>
---	--

INSTRUCTIONS: Use typewriter or ball point pen. Please press firmly and print clearly. Please fill in blanks, underline or circle the correct answers. Send top three copies to Kansas Department of Health and Environment, Bureau of Water, Topeka, Kansas 66620-0001. Telephone: 785/296-3565. Send one to Water Well Owner and retain one for your records.