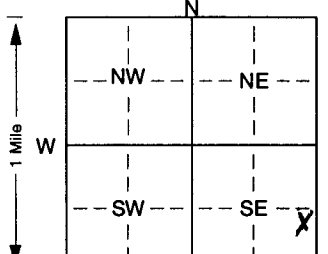


1] LOCATION OF WATER WELL: Fraction <u>NE 1/4 SE 1/4 SE 1/4</u> Section Number <u>26</u> Township Number <u>26</u> Range Number <u>1</u> E/W <u>W</u>	
County: <u>Sedgwick</u> Distance and direction from nearest town or city street address of well if located within city? <u>NW Corner West Street & 37th Street North Wichita, KS</u>	
2] WATER WELL OWNER: <u>CD Recyclers</u> RR#, St. Address, Box #: <u>P.O. Box 7717</u> Board of Agriculture, Division of Water Resources City, State, ZIP Code: <u>Wichita, KS</u> Application Number:	
3] LOCATE WELL'S LOCATION WITH AN "X" IN SECTION BOX:	4] DEPTH OF COMPLETED WELL: <u>25</u> ft. ELEVATION: <u>7-10-02</u>

Was a chemical/bacteriological sample submitted to Department? Yes. <u>No</u> <u>X</u> ; If yes, mo/day/yr sample was submitted Water Well Disinfected? Yes <u>No</u> <u>X</u>	
5] TYPE OF BLANK CASING USED: 1 Steel 3 RMP (SR) 5 Wrought iron 8 Concrete tile CASING JOINTS: Glued. <u>Clamped.</u> <u>2 PVC</u> 4 ABS 6 Asbestos-Cement 9 Other (specify below) Welded <u>Threaded</u> <u>X</u> Blank casing diameter <u>2</u> in. 
TYPE OF SCREEN OR PERFORATION MATERIAL: 1 Steel 3 Stainless steel 5 Fiberglass <u>7 PVC</u> 10 Asbestos-cement 2 Brass 4 Galvanized steel 6 Concrete tile 8 RMP (SR) 11 Other (specify) <u>12 None used (open hole)</u> SCREEN OR PERFORATION OPENINGS ARE: 1 Continuous slot <u>3 Mill slot</u> 5 Gauzed wrapped 8 Saw cut 11 None (open hole) 2 Louvered shutter 4 Key punched 6 Wire wrapped 9 Drilled holes 7 Torch cut 10 Other (specify) <u>ft.</u>	
SCREEN-PERFORATED INTERVALS: From <u>15</u> ft. to <u>25</u> ft., From <u>15</u> ft. to <u>25</u> ft., From <u>15</u> ft. to <u>25</u> ft. GRAVEL PACK INTERVALS: From <u>13</u> ft. to <u>25</u> ft., From <u>13</u> ft. to <u>25</u> ft., From <u>13</u> ft. to <u>25</u> ft.	
6] GROUT MATERIAL: 1 Neat cement 2 Cement grout <u>3 Bentonite</u> 4 Other <u>Waste Transfer Station</u> Grout Intervals: From <u>1</u> ft. to <u>13.0</u> ft., From <u>13.0</u> ft. to <u>25</u> ft., From <u>25</u> ft. to <u>25</u> ft. What is the nearest source of possible contamination: 10 Livestock pens 14 Abandoned water well 1 Septic tank 4 Lateral lines 7 Pit privy 11 Fuel storage 15 Oil well/Gas well 2 Sewer lines 5 Cess pool 8 Sewage lagoon 12 Fertilizer storage 16 Other (specify below) 3 Watertight sewer lines 6 Seepage pit 9 Feedyard 13 Insecticide storage Direction from well? <u>West</u> How many feet? <u>400</u>	
FROM TO LITHOLOGIC LOG	FROM TO PLUGGING INTERVALS
0.0 3.0 DK BR F CL (F:11)	
3.0 4.0 BR F CL (F:11)	
4.0 5.0 RD BR Sandy CL	
5.0 13.0 GR BR Sandy CL	
13.0 25.0 GR F.M. Wet Sand	
7] CONTRACTOR'S OR LANDOWNER'S CERTIFICATION: This water well was (1) constructed, (2) reconstructed, or (3) plugged under my jurisdiction and was completed on (mo/day/year) <u>8-1-92</u> and this record is true to the best of my knowledge and belief. Kansas Water Well Contractor's Licence No. <u>#654</u> This Water Well Record was completed on (mo/day/yr) <u>8-1-92</u> under the business name of <u>Thornburg Contract Drilling L.L.C.</u> by (signature) <u>Charles S. Thornburg</u>	
INSTRUCTIONS: Use typewriter or ball point pen. PLEASE PRESS FIRMLY and PRINT clearly. Please fill in blanks, underline or circle the correct answers. Send top three copies to Kansas Department of Health and Environment, Bureau of Water, Topeka, Kansas 66620-0001. Telephone 785-296-5524. Send one to WATER WELL OWNER and retain one for your records. Fee of \$5.00 for each constructed well.	