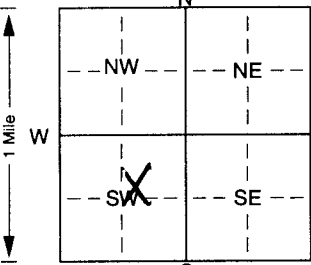


1 LOCATION OF WATER WELL: Fraction SW 1/4 NE 1/4 SW 1/4 Section Number 33 Township Number T 26 Range Number R 10
County: Sedgwick
Distance and direction from nearest town or city street address of well if located within city? See below

2 WATER WELL OWNER: Troy Alexander
RR#, St. Address, Box #: 3033 Pepperidge Board of Agriculture, Division of Water Resources
City, State, ZIP Code: Wichita, KS 67205 Application Number:

3 LOCATE WELL'S LOCATION WITH AN "X" IN SECTION BOX:

 4 DEPTH OF COMPLETED WELL: 70 ft. ELEVATION: 3-15-02 ft.
 Depth(s) Groundwater Encountered: 35 ft. 2. 35 ft. 3. 35 ft.
 WELL'S STATIC WATER LEVEL: 35 ft. below land surface measured on mo/day/yr
 Bore Hole Diameter: 11 in. to 70 ft. and 70 in. to 70 ft.
 WELL WATER TO BE USED AS: 5 Public water supply 8 Air conditioning 11 Injection well
 1 Domestic 3 Feedlot 6 Oil field water supply 9 Dewatering 12 Other (Specify below)
 2 Irrigation 4 Industrial 7 Domestic (lawn & garden) 10 Monitoring well
 Was a chemical/bacteriological sample submitted to Department? Yes. No; If yes, mo/day/yr sample was submitted
 Water Well Disinfected? Yes X No

5 TYPE OF BLANK CASING USED:
 1 Steel 3 RMP (SR) 6 Asbestos-Cement 9 Other (specify below)
 2 PVC 4 ABS 7 Fiberglass
 Blank casing diameter: 12 in. to 61 ft. Dia 2.40 in. to 160 psi ft.
 Casing height above land surface: 12 in. weight 2.40 lbs./ft. Wall thickness or gauge No. 160 psi
 TYPE OF SCREEN OR PERFORATION MATERIAL:
 1 Steel 3 Stainless steel 5 Fiberglass 8 RMP (SR) 10 Asbestos-cement
 2 Brass 4 Galvanized steel 6 Concrete tile 9 ABS 11 Other (specify)
 12 None used (open hole)
 SCREEN OR PERFORATION OPENINGS ARE:
 1 Continuous slot 3 Mill slot 5 Gauzed wrapped 8 Saw cut 11 None (open hole)
 2 Louvered shutter 4 Key punched 6 Wire wrapped 9 Drilled holes
 7 Torch cut 10 Other (specify) 70 ft.
 SCREEN-PERFORATED INTERVALS: From 35 ft. to 70 ft. From 35 ft. to 70 ft.
 GRAVEL PACK INTERVALS: From 35 ft. to 70 ft. From 35 ft. to 70 ft.

6 GROUT MATERIAL: 3 1 Neat cement 2 Cement grout 3 Bentonite 4 Other
 Grout Intervals: From 35 ft. to 70 ft. From 35 ft. to 70 ft.
 What is the nearest source of possible contamination:
 1 Septic tank 4 Lateral lines 7 Pit privy 10 Livestock pens 14 Abandoned water well
 2 Sewer lines 5 Cess pool 8 Sewage lagoon 11 Fuel storage 15 Oil well/Gas well
 3 Watertight sewer lines 6 Seepage pit 9 Feedyard 12 Fertilizer storage 16 Other (specify below)
 13 Insecticide storage
 Direction from well? West How many feet? 30

FROM	TO	LITHOLOGIC LOG	FROM	TO	PLUGGING INTERVALS
0	3	clay			
3	18	fine sand			
18	22	clay			
22	32	fine sand			
32	36	clay			
36	52	sand			
52	65	clay			
65	66	med sand			
66	70	clay			
		fine sand			

7 CONTRACTOR'S OR LANDOWNER'S CERTIFICATION: This water well was (1) constructed, (2) reconstructed, or (3) plugged under my jurisdiction and was completed on (mo/day/year) 3-15-02 and this record is true to the best of my knowledge and belief. Kansas
 Water Well Contractor's Licence No. 318 This Water Well Record was completed on (mo/day/yr) 3-21-02
 under the business name of Weninger Drilling Inc by (signature) Dickell Eargle