

CORRECTION(S) TO WATER WELL RECORD (WWC-5)

(to rectify lacking or incorrect information)

County: Sedgwick

Location listed as:

Location changed to:

Section-Township-Range: 19-26-1W

19-26S-1W

Fraction ($\frac{1}{4}$ $\frac{1}{4}$ $\frac{1}{4}$): None Given

SE SE SE

Other changes: Initial statements: _____

Changed to: _____

Comments: _____

verification method: Well address, city map, and

Maize 1:24,000 topo. map.

initials: DRd date: 11/8/2004

submitted by: Kansas Geological Survey, Data Resources Library, 1930 Constant Ave., Lawrence, KS 66047-3726
to: Kansas Dept of Health & Environment, Bureau of Water, 1000 SW Jackson, Suite 420, Topeka, KS 66612-1367.

1 LOCATION OF WATER WELL:	Fraction	Section Number	Township Number	Range Number
County: <u>SEDGEWICK</u>	<u>1/4 1/4 1/4</u>	<u>19</u>	<u>26</u>	<u>1W</u>

Distance and direction from nearest town or city street address of well if located within city?


4615 N. MAIZE RD. MAIZE, KAN.

2 WATER WELL OWNER:

RR#, St. Address, Box #: 4615 N. MAIZERD. Board of Agriculture, Division of Water Resources
City, State, ZIP Code: MAIZE, KS. 67101 Application Number:

3 MARK WELL'S LOCATION WITH AN "X" IN SECTION BOX:

N

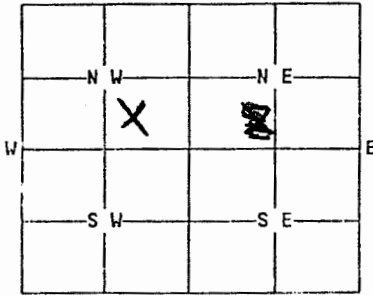

S

4 DEPTH OF WELL.....40.....ft.WELL'S STATIC WATER LEVEL. 20.....ft.

WELL WAS USED AS:

- | | | |
|--|---|---|
| ☒ 1 Domestic | ☐ 5 Public Water Supply | ☐ 9 Dewatering |
| ☐ 2 Irrigation | ☐ 6 Oil Field Water Supply | ☐ 10 Monitoring Well |
| ☐ 3 Feedlot | ☐ 7 Lawn and Garden Only | ☐ 11 Injection Well |
| ☐ 4 Industrial | ☐ 8 Air Conditioning | ☐ 12 Other..... |

Was a chemical/bacteriological sample submitted to Department? Yes.....No.
If yes, mo/day/yr sample was submitted.....Water Well Disinfected: Yes X No.....

5 TYPE OF BLANK CASING USED:

- | | | | | |
|---|-------------------------------------|--|--|--|
| ☒ 1 Steel | ☐ 3 RMP (SR) | ☐ 5 Wrought | ☐ 7 Fiberglass | ☐ 9 Other (specify below) |
| ☒ 2 PVC | ☐ 4 ABS | ☐ 6 Asbestos-Cement | ☐ 8 Concrete Tile | |

Blank casing diameter.....5.....in. Was casing pulled? Yes..... No X If yes, how much.....Casing height above or below land surface.....0.....in. EVEN WITH FLOOR6 GROUT PLUG MATERIAL: 1 Neat cement ☒ 2 Cement grout 3 Bentonite 4 Other.....Grout Plug Intervals: From...3..ft. to...0..ft., From.....ft. toft., From..... to.....

What is the nearest source of possible contamination:

- | | | | |
|---|--|--|--|
| ☐ 1 Septic tank | ☐ 6 Seepage pit | ☐ 11 Fuel storage | ☒ 16 Other (specify below) |
| ☐ 2 Sewer lines | ☐ 7 Pit privy | ☐ 12 Fertilizer storage | <u>Termite treat.</u> |
| ☐ 3 Watertight sewer lines | ☐ 8 Sewage lagoon | ☐ 13 Insecticide storage | |
| ☐ 4 Lateral lines | ☐ 9 Feedyard | ☐ 14 Abandoned water well | |
| ☐ 5 Cess Pool | ☐ 10 Livestock pens | ☐ 15 Oil well/Gas well | |

Direction from well? WestHow many feet? 10

FROM	TO	PLUGGING MATERIALS
40	20	Chlorinated Gravel
20	3	Pea Gravel
3	0	Portland Cement

RECEIVED

OCT 19 2004

BUREAU OF WATER

7 CONTRACTOR'S OR LANDOWNER'S CERTIFICATION: This water well was plugged under my jurisdiction and was completed on (mo/day/year) 5-13-04 and this record is true to the best of my knowledge and belief. K
Water Well Contractor's License No. 5-13-04 This Water Well Record was completed on (mo/day/year) 5-13-04 under the business name of Nogt Construction
by (signature) Stow

INSTRUCTIONS: Use typewriter or ball point pen. Please press firmly and print clearly. Please fill in blanks, underline or the correct answers. Send top three copies to Kansas Department of Health and Environment, Bureau of Water, Topeka, K 66620-0001. Telephone: 785/296-3565. Send one to Water Well Owner and retain one for your records.