

1	LOCATION OF WATER WELL:	Fraction	Section Number	Township Number	Range Number
County:	Sedawick	SW $\frac{1}{4}$ SW $\frac{1}{4}$ NE $\frac{1}{4}$	34	T 26 S S	R 1 W E/W

Distance and direction from nearest town or city street address of well if located within city?


10213 W. 34th St. N.

2 WATER WELL OWNER: James Smith
RR#, St. Address, Box # : 6213 W. 34th st. n.
City, State, ZIP Code : Wichita, KS

Board of Agriculture, Division of Water Resources
Application Number:

3	LOCATE WELL'S LOCATION WITH	4	DEPTH OF COMPLETED WELL 40 ft. ELEVATION:
---	-----------------------------	---	---

AN "X" IN SECTION BOX:

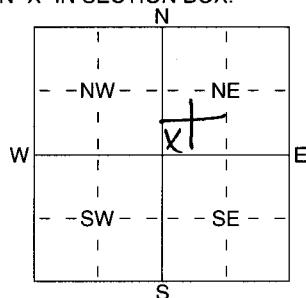

Depth(s) Groundwater Encountered	1	16	ft	2		ft	3		ft
----------------------------------	---	----	----	---	--	----	---	--	----

Depth(s) Groundwater Encountered 1 16 ft. 2 _____ ft. 3 _____ ft.
WELL'S STATIC WATER LEVEL 16 ft. below land surface measured on mo/day/yr _____

Pump test data: Well water was ft. after hours pumping gpm

Est. Yield gpm: Well water was ft. after hours pumping gpm

WELL WATER TO BE USED AS: 5 Public water supply 8 Air conditioning 11 Injection well

1 Domestic	3 Feedlot	6 Oil field water supply	9 Dewatering	12 Other (Specify below)
------------	-----------	--------------------------	--------------	--------------------------

2 Irrigation 4 Industrial 7 Domestic (lawn & garden) 10 Monitoring well

Was a chemical/bacteriological sample submitted to Department? Yes No ~~X~~; If yes, mo/day/yr sample was submitted

5	TYPE OF BLANK CASING USED:
---	----------------------------

1 Steel
2 PVC
3 RMP (SR)
4 ABS

.....
 ank casing diameter 5 in. to 40 ft., Dia in. to ft., Dia in. to ft.

Casing height above land surface 16 in., weight 160 lbs./ft. Wall thickness or gauge No. 26

TYPE OF SCREEN OR PERFORATION MATERIAL:

1 Steel	3 Stainless Steel	5 Fiberglass	8 RMP (SR)	11 Other (Specify)
2 Brass	4 Galvanized Steel	6 Concrete tile	9 ABS	12 None used (open hole)

SCREEN OR PERFORATION OPENINGS ARE:

1 Continuous slot 3 Mill slot 6 Wire wrapped 9 Drilled holes
2 Louvered shutter 4 Key punched 7 Torch cut 10 Other (specify)ft.

SCREEN-PERFORATED INTERVALS: From 30 ft. to 40 ft., From _____ ft. to _____ ft.

From ft. to ft., From ft. to ft.

GRAVEL PACK INTERVALS: From 24 ft. to 40 ft., From _____ ft. to _____ ft.
From _____ ft. to _____ ft., From _____ ft. to _____ ft.

6 GROUT MATERIAL: 1 Neat cement, 2 Cement grout, 3 Bentonite, 4 Other


What is the nearest source of possible contamination:

1 Septic tank	4 Lateral lines	7 Pit privy	11 Fuel storage	15 Oil well/Gas well
2 Sewer lines	5 Cess pool	8 Sewage lagoon	12 Fertilizer storage	16 Other (specify below)
3 Watertight sewer lines	6 Seepage pit	9 Feedyard	13 Insecticide storage	

Direction from well? Southeast How many feet? 105

FROM	TO	LITHOLOGIC LOG	FROM	TO	PLUGGING INTERVALS
------	----	----------------	------	----	--------------------

mm	g	ETHIOLOGICAL
0	4	topsoil
4	13	clay - Fine Sand
13	40	Coarse Sand - gravel

7 CONTRACTOR'S OR LANDOWNER'S CERTIFICATION: This water well was (1) constructed, (2) reconstructed, or (3) plugged under my jurisdiction and was completed on (mo/day/year) 11-9-04 and this record is true to the best of my knowledge and belief. Kansas Water Well Contractor's Licence No. Cell This Water Well Record was completed on (mo/day/yr) 2-22-05 under the business name of Chase Drilling by (signature) [Signature]