


1	LOCATION OF WATER WELL: Sedgwick	FRACTION NW 1/4 NW 1/4 SW 1/4	SECTION NUMBER 32	TOWNSHIP NUMBER T 26 S	RANGE NUMBER R 1W E/W
---	--	---	-----------------------------	----------------------------------	---------------------------------

Distance and direction from nearest town or city street address of well if located within city?

9250 Westlake Parkway-600' North of Westlakes Parkway, 105' East of center of Maize Rd.		Wichita, Kansas
2	WATER WELL OWNER: SHELLENBERG DEVELOPMENT	
	RR#,ST. ADDRESS,BOX #: 7926 W. 21st, STE. # 200	Board of Agriculture, Division of Water Resource
	CITY, STATE: Wichita, Kansas	Application Number:
	ZIP CODE: 67205	

3 LOCATE WELL'S LOCATION
WITH AN "X" IN SECTION BOX:

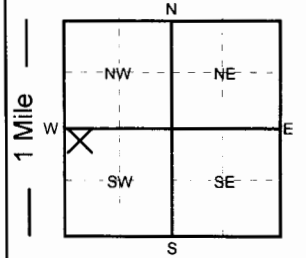

4 DEPTH OF COMPLETED WELL:		120		ft.		ELEVATION:					
Depth of groundwater Encountered:				ft.				ft.			
WELL'S STATIC WATER LEVEL		20		FT. BELOW LAND SURFACE MEASURED ON		mo/day/yr:		6/8/05			
Pump test data:		Well water was				ft. after		hours of pumping @		gpm	
Est. Yield:		gpm		Well water was		ft. after		hours of pumping @		gpm	
Bore Hole Diameter		15		in.		to 120		ft.		and in. to ft.	
WELL WATER TO BE USED AS:								9. Dewatering		11. Injection well	
1. Domestic		3. Feedlot		5. Public water supply		7. Lawn and garden only				12. Other (Specify below)	
2. Irrigation		4. Industrial		6. Oil field water supply		8. Air conditioning		10. Monitoring well			
Was a chemical/bacteriological sample submitted to Department?		YES		NO				; If yes, what mo/day/yr was sample			
submitted				Was Water Well Disinfected?		YES		NO			

TYPE OF CASING USED: 1. Steel 3. RPM (SR) 2. PVC 4. ABS Blank casing diameter 8 in. to 88 ft., Dia. in. to ft., Dia. in. to ft.		5. Wrought Iron 7. Fiberglass 9. Other (Specify below) 6. Asbestos-Cement 8. Concrete tile SDR-26		CASING JOINTS: Glued Threaded Welded Clamped	
Casing height above land surface: 12 in., Weight: 5.52 lbs. / ft. Wall thickness or gauge No. .332					
TYPE OF SCREEN OR PERFORATION MATERIAL: 1. Steel 3. Stainless Steel 5. Fiberglass 7. PVC 9. ABS 11. Other (specify) 2. Brass 4. Galvanized 6. Concrete Tile 8. RMP (SR) 10. Asbestos-Cement 12. None used (open hole)					
SCREEN OR PERFORATION OPENINGS ARE: 1. Continuous slot 3. Mill slot 5. Gauzed wrapped 7. Torch cut 9. Drilled holes 11. None (open hole) 2. Louvered shutter 4. Key punched 6. Wire wrapped 8. Saw cut 10. Other (specify)					
SCREEN - PERFORATION INTERVAL From 88 ft. to 120 ft., From ft. to ft.					
From ft. to ft., From ft. to ft.					
GRAVEL PACK INTERVALS: From 24 ft. to 120 ft., From ft. to ft.					
From ft. to ft., From ft. to ft.					

6	GROUT MATERIALS:		1. Neat cement		2. Cement Grout		3. Bentonite		Other		bentonite hole plug		
	Grout Intervals:		From	4 ft.	to	24 ft.,	From	ft.	to	ft.,	From	ft.	to
What is the nearest source of possible contamination:													
1. Septic tank		4. Lateral lines		7. Pit privy		10. Livestock pens		13. Insecticide storage		15. Oil well/Gas well			
2. Sewer lines		5. Cess Pool		8. Sewage lagoon		11. Fuel storage		14. Abandon water well		16. Other (specify below)			
3. Watertight sewer line		6. Seepage pit		9. Feed yard		12. Fertilizer storage							
Direction from well?				East				How many feet? 50 feet plus					

[illegible]

7 Contractor's or Landowner's Certification: This water well was 1. **constructed** 2. **reconstructed** or 3. **plugged** under my jurisdiction and was completed on (mo/day/year) **6/8/2005** and this record is true to the best of my knowledge and belief.

Kansas Water Well Contractor's License No. **236** This water well record was completed on (mo/day/year) **6/10/2005**

under the business name of **Harp Well & Pump Service Inc.** by (signature) *Jo dd S. Harp*