NW SW SW SE

WATER WELL RECORD Form WWC-5 KSA 82a-1212 ID No. _____

1 LOCATION OF WATER WELL: County: Sedgwick | Fraction: ¼ SE ¼ SW ¼ SW | Section Number: 33 | Township Number: T 27S | Range Number: R 1 E W

Distance and direction from nearest town or city street address of well if located within city? 3103 Lakecrest Circle Wichita, KS. 26

2 WATER WELL OWNER: Ron Riley 67205

RR#, St. Address, Box # : 3103 Lakecrest Circle. Wichita, KS

City, State, ZIP Code :

Board of Agriculture, Division of Water Resources Application Number:

3 LOCATE WELL'S LOCATION WITH AN "X" IN SECTION BOX:

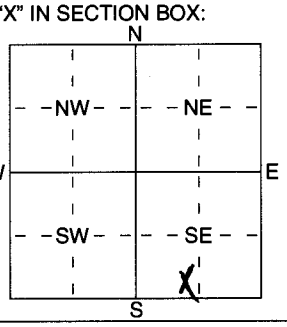

4 DEPTH OF COMPLETED WELL 50 ft. ELEVATION:

Depth(s) Groundwater Encountered 1 20 ft. 2 ft. 3 ft.

WELL'S STATIC WATER LEVEL 20 ft. below land surface measured on mo/day/yr

Pump test data: Well water was ft. after hours pumping gpm

Est. Yield 25 gpm: Well water was ft. after hours pumping gpm

WELL WATER TO BE USED AS: 1 Domestic 2 Irrigation 3 Feedlot 4 Industrial 5 Public water supply 6 Oil field water supply 7 Domestic (lawn & garden) 8 Air conditioning 9 Dewatering 10 Monitoring well 11 Injection well 12 Other (Specify below)

Was a chemical/bacteriological sample submitted to Department? Yes No X; If yes, mo/day/yrs sample was submitted

Water Well Disinfected? (Yes) No

5 TYPE OF BLANK CASING USED: 1 Steel (2) PVC 3 RMP (SR) 4 ABS 5 Wrought iron 6 Asbestos-Cement 7 Fiberglass 8 Concrete tile 9 Other (specify below)

CASING JOINTS: Glued X Clamped Welded Threaded

Blank casing diameter 5 in. to 40 ft., Dia in. to ft., Dia in. to ft.

Casing height above land surface 12 in., weight 2.40 lbs./ft. Wall thickness or guage No. 160 PSI

TYPE OF SCREEN OR PERFORATION MATERIAL: (0) PVC 1 Steel 2 Brass 3 Stainless Steel 4 Galvanized Steel 5 Fiberglass 6 Concrete tile 8 RMP (SR) 9 ABS 10 Asbestos-Cement 11 Other (Specify) 12 None used (open hole)

SCREEN OR PERFORATION OPENINGS ARE: 1 Continuous slot (3) Mill slot 2 Louvered shutter 4 Key punched 5 Guazed wrapped 6 Wire wrapped 7 Torch cut 8 Saw cut 9 Drilled holes 10 Other (specify) 11 None (open hole)

SCREEN-PERFORATED INTERVALS: From 40 ft. to 50 ft., From ft. to ft.

From 20 ft. to ft., From ft. to ft.

GRAVEL PACK INTERVALS: From 20 ft. to 50 ft., From ft. to ft.

From ft. to ft., From ft. to ft.

6 GROUT MATERIAL: 1 Neat cement 20 2 Cement grout (3) Bentonite 4 Other

Grout Intervals: From 3 ft. to 20 ft., From ft. to ft., From ft. to ft.

What is the nearest source of possible contamination: 1 Septic tank 2 Sewer lines (3) Watertight sewer lines 4 Lateral lines 5 Cess pool 6 Seepage pit 7 Pit privy 8 Sewage lagoon 9 Feedyard 10 Livestock pens 11 Fuel storage 12 Fertilizer storage 13 Insecticide storage 14 Abandoned water well 15 Oil well/Gas well 16 Other (specify below)

Direction from well? NORTH How many feet? 20

FROM	TO	LITHOLOGIC LOG	FROM	TO	PLUGGING INTERVALS
0	25	Clay			
25	30	Fine Sand			
30	50	Med Sand			

7 CONTRACTOR'S OR LANDOWNER'S CERTIFICATION: This water well was (1) constructed, (2) reconstructed, or (3) plugged under my jurisdiction and was completed on (mo/day/year) 7-22-04 and this record is true to the best of my knowledge and belief. Kansas Water Well Contractor's Licence No 740 This Water Well Record was completed on (mo/day/yr) 7-22-04 under the business name of Wenninger Drilling inc. by (signature)

INSTRUCTIONS: Use typewriter or ball point pen. *PLEASE PRESS FIRMLY* and *PRINT* clearly. Please fill in blanks, underline or circle the correct answers. Send top three copies to Kansas Department of Health and Environment, Bureau of Water, Geology Section, 1000 SW Jackson St., Suite 420, Topeka, Kansas 66612-1367. Telephone 785-296-5522. Send one to WATER WELL OWNER and retain one for your records. Fee of $5.00 for each constructed well.