MW-104 WATER WELL RECORD Form WWC-5 KSA 82a-1212 ID No. _____

1 LOCATION OF WATER WELL:

County:	Fraction	Section Number	Township Number	Range Number
Sedgwick	SE ¼ NE ¼ SE ¼	1	T 26 S	R 1 E/W

Distance and direction from nearest town or city street address of well if located within city?
1120 North Meridian Avenue, Valley Center, KS, Lat: N 37° 48.934' Long: W 97° 22.367'

2 WATER WELL OWNER: BP Amoco
RR#, St. Address, Box # : Box 15748
City, State, ZIP Code : Shawnee Mission, KS 66285

Board of Agriculture, Division of Water Resources
Application Number:

3 LOCATE WELL'S LOCATON WITH AN "X" IN SECTION BOX:

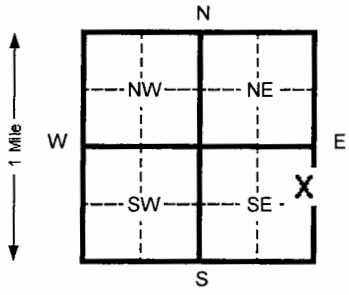

4 DEPTH OF COMPLETED WELL 25 ft. ELEVATION: Unknown

Depth(s) Groundwater Encountered 1 Unknown ft. 2 _____ ft. 3 _____ ft.

WELL'S STATIC WATER LEVEL Unk. ft. below land surface measured on mo/day/yr --

Pump test data: Well water was N/A ft. after _____ hours pumping _____ gpm

Est. Yield N/A gpm: Well water was N/A ft. after _____ hours pumping _____ gpm

Bore Hole Diameter 8 in. to 25 ft. and _____ in. to _____ ft.

WELL WATER TO BE USED AS: 1 Domestic 3 Feed lot 5 Public water supply 6 Oil field water supply 7 Lawn and garden (domestic) 8 Air conditioning 9 Dewatering 10 Monitoring well 11 Injection well 12 Other (Specify below) 2 Irrigation 4 Industrial

Was a chemical/bacteriological sample submitted to Department? Yes _____ No X If yes, mo/day/yr sample was submitted

Water Well Disinfected? Yes _____ No X

5 TYPE OF BLANK CASING USED: 1 Steel 2 PVC 3 RMP (SR) 4 ABS 5 Wrought Iron 6 Asbestos-Cement 7 Fiberglass 8 Concrete tile 9 Other (specify below)

CASING JOINTS: Glued _____ Clamped _____ Welded _____ Threaded _____

Blank casing diameter 2 in. to 15 ft., Dia _____ in. to _____ ft., Dia _____ in. to _____ ft.

Casing height above land surface 0 in., weight 0.682 lbs./ft. Wall thickness or gauge No. 0.1875 in.

TYPE OF SCREEN OR PERFORATION MATERIAL: 1 Steel 2 Brass 3 Stainless steel 4 Galvanized steel 5 Fiberglass 6 Concrete tile 7 PVC 8 RMP (SR) 9 ABS 10 Asbestos-cement 11 Other (specify) _____ 12 None used (open hole)

SCREEN OR PERFORATION OPENINGS ARE: 1 Continuous slot 2 Louvered shutter 3 Mill slot 4 Key punched 5 Gauzed wrapped 6 Wire wrapped 7 Torch cut 8 Saw cut 9 Drilled holes 10 Other (specify) _____ 11 None (open hole)

SCREEN-PERFORATED INTERVALS: From 15 ft. to 25 ft. From _____ ft. to _____ ft.
From _____ ft. to _____ ft. From _____ ft. to _____ ft.

GRAVEL PACK INTERVALS: From 13 ft. to 25 ft. From _____ ft. to _____ ft.
From _____ ft. to _____ ft. From _____ ft. to _____ ft.

6 GROUT MATERIAL: 1 Neat cement 2 Cement grout 3 Bentonite 4 Other _____

Grout Intervals From 1 ft. to 13 ft. From _____ ft. to _____ ft. From _____ ft. to _____ ft.

What is the nearest source of possible contamination:
1 Septic tank 2 Sewer lines 3 Watertight sewer lines 4 Lateral lines 5 Cess pool 6 Seepage pit 7 Pit privy 8 Sewage lagoon 9 Feedyard 10 Livestock pens 11 Fuel storage 12 Fertilizer storage 13 Insecticide storage 14 Abandoned water well 15 Oil well/ Gas well 16 Other (specify below) _____

Direction from well? northeast How many feet? approximately 50 feet

FROM	TO	CODE	LITHOLOGIC LOG	FROM	TO	PLUGGING INTERVALS
0	25	03	brown, silty clay			

7 CONTRACTOR'S OR LANDOWNER'S CERTIFICATION: This water well was (1) constructed, (2) reconstructed, or (3) plugged under my jurisdiction and was completed on (mo/day/yr) 6/1/06 and this record is true to the best of my knowledge and belief. Kansas Water Well Contractor's License No. 616 This Water Well Record was completed on (mo/day/yr) 12/26/06 under the business name of Thiele Geotech, Inc. by (signature) [signature]

INSTRUCTIONS:. Please fill in blanks and circle the correct answers. Send three copies to Kansas Department of Health and Environment, Bureau of Water, 1000 S W Jackson St., Ste. 420, Topeka, Kansas 66612-1367. Telephone: 913-296-5545. Send one to WATER WELL OWNER and retain one for your records.

OFFICE USE ONLY T R SEC

Form provided by Forms-On-A-Disk, Inc. · Dallas, Texas · (214) 340-9429