


4250 W. 35th St. N. – Wichita

RR#, St. Address, Box # : 2060 E. Tulsa
City, State, ZIP Code : Wichita, KS 67216

Board of Agriculture, Division of Water Resources
Application Number:

4	DEPTH OF COMPLETED WELL	55	ft. ELEVATION:
---	-------------------------	----	----------------

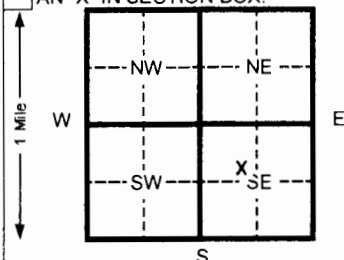

Depth(s) Groundwater Encountered 1 13.65 ft. 2 _____ ft. 3 _____ ft.

WELL'S STATIC WATER LEVEL _____ ft. below land surface measured on mo/day/yr _____

Pump test data: Well water was _____ ft. after _____ hours pumping _____ gpm

Est. Yield _____ gpm: Well water was _____ ft. after _____ hours pumping _____ gpm

Bore Hole Diameter 8 in. to 55 ft. and _____ in. to _____ ft.

WELL WATER TO BE USED AS:

5 Public water supply	8 Air conditioning	11 Injection well		
1 Domestic	3 Feed lot	6 Oil field water supply	9 Dewatering	12 Other (Specify below)
2 Irrigation	4 Industrial	7 Lawn and garden (domestic)	<u>10 Monitoring well</u>	

Was a chemical/bacteriological sample submitted to Department? Yes _____ No X If yes, mo/day/yr sample was submitted _____

Water Well Disinfected? Yes _____ No X

5	Wrought Iron	8	Concrete tile	CASING JOINTS: Glued	Clamped
---	--------------	---	---------------	----------------------	---------

1 Steel	3 RMP (SR)
2 PVC	4 ABS

5 Wrought Iron	8 Concrete tile
6 Asbestos-Cement	9 Other (specify below)
7 Fiberglass	

CASING JOINTS: Glued Clamped

Threaded Flush

Blank casing diameter	2	in. to	45	ft., Dia	in. to	ft., Dia	in. to	ft.
-----------------------	---	--------	----	----------	--------	----------	--------	-----

Casing height above land surface	36	in., weight	0.703	lbs./ft. Wall thickness or gauge No.	SCH. 40
----------------------------------	----	-------------	-------	--------------------------------------	---------

TYPE OF SCREEN OR PERFORATION MATERIAL:

7 PVC	10 Asbestos-cement
-------	--------------------

1 Steel	3 Stainless steel	5 Fiberglass	8 RMP (SR)	11 Other (specify) _____
2 Brass	4 Galvanized steel	6 Concrete tile	9 ABS	12 None used (open hole)

SCREEN OR PERFORATION OPENINGS ARE:

SCREEN OR PERFORATION OPENINGS ARE:

1 Continuous slot	3 Mill slot	5 Gauzed wrapped	8 Saw cut	11 None (open hole)
2 Louvered shutter	4 Key punched	6 Wire wrapped	9 Drilled holes	
		7 Torch cut	10 Other (specify)	

SCREEN-PERFORATED INTERVALS: From **45** ft. to **55** ft. From _____ ft. to _____ ft.

GRAVEL PACK INTERVALS: From **43** ft. to **55** ft. From _____ ft. to _____ ft.

6	GROUT MATERIAL:	1 Neat cement	2 Cement grout	3 Bentonite	4 Other
---	-----------------	---------------	----------------	-------------	---------

Grout Intervals	From	ft. to	ft.	From	ft. to	ft.	From	ft. to	ft.
	2	43							

What is the nearest source of possible contamination:

1 Septic tank	4 Lateral lines	7 Pit privy	11 Fuel storage	15 Oil well/ Gas well
2 Sewer lines	5 Cess pool	8 Sewage lagoon	12 Fertilizer storage	16 Other (specify below)
3 Watertight sewer lines	6 Seepage pit	9 Feedyard	13 Insecticide storage	

Direction from well?

How many feet?

FROM	TO	CODE	LITHOLOGIC LOG	FROM	TO	PLUGGING INTERVALS
0	3		Topsoil, dark brown			
3	6		Clay, dark brown			
6	18		Sand, red brown, fine grained			
18	21		Sand and Silt, dark brown, medium to coarse grained			
21	55		Sand, tan, medium to coarse grained, coarsens with depth, with gravel below 34', contact with blue green shale at 55'			

7 CONTRACTOR'S OR LANDOWNER'S CERTIFICATION: This water well was (1) constructed, (2) reconstructed, or (3) plugged under my jurisdiction and was completed on (mo/day/yr) 08/01/11 and this record is true to the best of my knowledge and belief. Kansas

Water Well Contractor's License No. **531** This Water Well Record was completed on (mo/day/yr) **08/05/11**

under the business name of **Geotechnical Services Inc.**

by (signature) Daniel E. Jones

INSTRUCTIONS: Please fill in blanks and circle the correct answers. Send three copies to Kansas Department of Health and Environment, Bureau of Water, 1000 S W Jackson St., Ste. 420, Topeka, Kansas 66612-1367. Telephone: 913-296-5545. Send one to WATER WELL OWNER and retain one for your records.