


4250 W. 35th St. N. – Wichita

RR#, St. Address, Box # : 2060 E. Tulsa
City, State, ZIP Code : Wichita, KS 67216

Board of Agriculture, Division of Water Resources
Application Number:

3 LOCATE WELL'S LOCATON WITH AN "X" IN SECTION BOX:

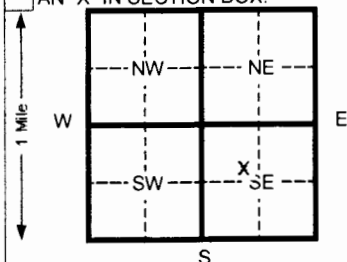

4 DEPTH OF COMPLETED WELL

30 ft. ELEVATION:

Depth(s) Groundwater Encountered	1	13.1	ft.	2		ft.	3		ft.
----------------------------------	---	------	-----	---	--	-----	---	--	-----

WELL'S STATIC WATER LEVEL _____ ft. below land surface measured on mo/day/yr _____

Pump test data: Well water was _____ ft. after _____ hours pumping _____ gpm

Est. Yield	gpm:	Well water was	ft. after	hours pumping	gpm

Bore Hole Diameter **8** in. to **30** ft. and in. to ft.

WELL WATER TO BE USED AS:	5 Public water supply	8 Air conditioning	11 Injection well
---------------------------	-----------------------	--------------------	-------------------

1 Domestic 3 Feed lot 6 Oil field water supply 9 Dewatering 12 Other (Specify below)

2 Irrigation	4 Industrial	7 Lawn and garden (domestic)	10 Monitoring well
--------------	--------------	------------------------------	--------------------

Was a chemical/bacteriological sample submitted to Department? Yes ☐ No ☒ If yes, mo/day/yr sample was submitted _____

Water Well Disinfected? Yes ☐ No ☒

5	TYPE OF BLANK CASING USED:
---	----------------------------

1 Steel 3 RMP (SR)

2 PVC	4 ABS
-------	-------

5 Wrought Iron

8 Concrete tile

CASING JOINTS: Glued Clamped

6 Asbestos-Cement 9 Other (specify below)

7 Fiberglass

Blank casing diameter	2	in. to	20	ft., Dia		in. to	ft., Dia		in. to	ft.
-----------------------	---	--------	----	----------	--	--------	----------	--	--------	-----

Casing height above land surface	36	in., weight	0.703	lbs./ft. Wall thickness or gauge No.	SCH. 40
----------------------------------	----	-------------	-------	--------------------------------------	---------

TYPE OF SCREEN OR PERFORATION MATERIAL:

1 Steel	3 Stainless steel	5 Fiberglass	8 RMP (SR)	11 Other (specify) _____
2 Brass	4 Galvanized steel	6 Concrete tile	9 ABS	12 None used (open hole)



SCREEN OR PERFORATION OPENINGS ARE: 5 Gauzed wrapped 8 Saw cut 11 None (open hole)

1 Continuous slot	3 Mill slot	6 Wire wrapped	9 Drilled holes
2 Covered shutter	4 Key punched	7 Torch cut	10 Other (specify)

SCREEN-PERFORATED INTERVALS: From **20** ft. to **30** ft. From _____ ft. to _____ ft.

[illegible]

GRAVEL PACK INTERVALS: From **18** ft. to **30** ft. From _____ ft. to _____ ft.

[illegible]

6	GROUT MATERIAL:	1 Neat cement	2 Cement grout	3 Bentonite	4 Other
---	-----------------	---------------	----------------	-------------	---------

[illegible]

What is the nearest source of possible contamination:

1 Septic tank	4 Lateral lines	7 Pit privy	10 Fuel storage	13 Insecticide storage	16 Other (specify below)
2 Sewer lines	5 Cess pool	8 Sewage lagoon	11 Oil well/ Gas well		
3 Watertight sewer lines	6 Seepage pit	9 Feedyard	12 Fertilizer storage		

Direction from well?	How many feet?
----------------------	----------------

[illegible]

7 CONTRACTOR'S OR LANDOWNER'S CERTIFICATION: This water well was (1) constructed, (2) reconstructed, or (3) plugged under my jurisdiction and was completed on (mo/day/yr) **08/02/11** and this record is true to the best of my knowledge and belief. Kansas

Water Well Contractor's License No. **531** This Water Well Record was completed on (mo/day/yr) **08/05/11**
under the business name of **Geotechnical Services Inc.** by (signature) *David Edwards*

INSTRUCTIONS: Please fill in blanks and circle the correct answers. Send three copies to Kansas Department of Health and Environment, Bureau of Water, 1000 S W Jackson St., Ste. 420, Topeka, Kansas 66612-1367. Telephone: 913-296-5545. Send one to WATER WELL OWNER and retain one for your records.