

WATER WELL PLUGGING RECORD Form WWC-5P KSA 82a-1212 ID NO.

1 LOCATION OF WATER WELL: County: Sedgwick Fraction 1/4 NW 1/4 NE 1/4 SE 1/4 Section Number 12 Township Number T 26 S Range Number 1 ☐ E ☒ W

Street/Rural Address of Well Location; if unknown, distance & direction from nearest town or intersection: If at owner's address, check here ☒

Global Positioning Systems (GPS) information:

Latitude: (in decimal degrees)
Longitude: (in decimal degrees)
Elevation:

Datum: ☐ WGS84, ☐ NAD83, ☐ NAD27


Collection Method:

☐ GPS unit (Make/Model: _____)
☐ Digital Map/Photo, ☐ Topographic Map, ☐ Land Survey

Est. Accuracy: ☐ < 3 m, ☐ 3-5 m, ☐ 5-15 m, ☐ > 15 m

2 WATER WELL OWNER: Nick Barnard
RR#, St. Address, Box #: 6217 N. Edwards
City, State ZIP Code: Wichita, KS 67204

3 MARK WELL'S LOCATION WITH AN "X" IN SECTION BOX:

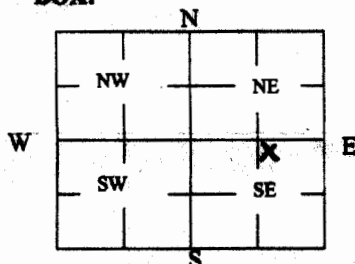

4 DEPTH OF WELL 40 ft.

WELL'S STATIC WATER LEVEL 20 ft.

WELL WAS USED AS:

☒ Domestic ☐ Public Water Supply ☐ Dewatering
☐ Irrigation ☐ Oil Field Water Supply ☐ Monitoring
☐ Feedlot ☐ Domestic (Lawn & Garden) ☐ Injection Well
☐ Industrial ☐ Air Conditioning ☐ Other _____

Was a chemical/bacteriological sample submitted to Department? Yes ☐ No ☒

5 TYPE OF BLANK CASING USED:

☐ Steel ☐ RMP (SR) ☐ Wrought ☐ Fiberglass ☐ Other (Specify below)
☒ PVC ☐ ABS ☐ Asbestos-Cement ☐ Concrete Tile

Blank casing diameter 5 in. Was casing pulled? Yes ☒ No ☐ If yes, how much 3'
Casing height above or below land surface 30 in.

6 GROUT PLUG MATERIAL: ☐ Neat cement ☐ Cement grout ☒ Bentonite ☐ Other

Grout Plug Intervals: From 3 ft. to 20 ft., From _____ ft. to _____ ft., From _____ to _____ ft.

What is the nearest source of possible contamination:

☐ Septic tank ☐ Seepage pit ☐ Fuel Storage ☐ Other (specify below)
☒ Sewer lines ☐ Pit privy ☐ Fertilizer storage
☐ Watertight sewer lines ☐ Sewage lagoon ☐ Insecticide storage
☐ Lateral lines ☐ Feedyard ☐ Abandoned water well
☐ Cess pool ☐ Livestock pens ☐ Oil well/Gas well

Direction from well? North
How many feet? 3

FROM	TO	PLUGGING MATERIALS	FROM	TO	PLUGGING MATERIALS
0	3	Topsoil			
3	20	Bentonite			
20	40	Sand			

7 CONTRACTOR'S OR LANDOWNER'S CERTIFICATION: This water well was plugged under my jurisdiction and was completed on (mo/day/year) 10/5/2012 and this record is true to the best of my knowledge and belief. Kansas Water Well Contractor's License No. 238 This Water Well Record was completed on (mo/day/year) 10/8/2012 under the business name of Premier Pump & Well Service, Inc. by signature [Signature]

INSTRUCTIONS: Use typewriter or ballpoint pen. Please press firmly and print clearly. Please fill in blanks, underline or circle the correct answers. Send top three copies to Kansas Department of Health and Environment, Bureau of Water, Geology Section, 1000 SW Jackson St., Ste. 420, Topeka, Kansas 66612-1367. Telephone: 785/296-5524. Send one to Water Well Owner and retain one for your records. Visit us at <http://www.kdheks.gov/waterwell/index.html>.

Check one: ☒ White Copy ☐ Blue Copy ☐ Pink Copy