

WATER WELL RECORD Form WWC-5

☒ Original Record ☐ Correction ☐ Change in Well Use

Division of Water
Resources App. No.

Well ID

1 LOCATION OF WATER WELL:

County: Sedgwick

Fraction: SE 1/4 NE 1/4 SW 1/4

Section Number: 31

Township Number: T 26 S


Range Number: R 1 E 1 W

2 WELL OWNER:

Last Name: Sacoa Homes First: Steve
Business: 400
Address: 727 N Waco
Address: Wichita State: KS ZIP: 67203

Street or Rural Address where well is located (if unknown, distance and direction from nearest town or intersection): If at owner's address, check here: ☐
11326 W Fontana St
Wichita, KS 67205

3 LOCATE WELL WITH "X" IN SECTION BOX:

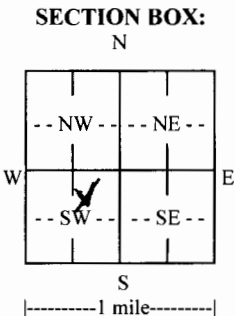

4 DEPTH OF COMPLETED WELL:

Depth(s) Groundwater Encountered: 1) 58 ft.
2) ft. 3) ft., or 4) ☐ Dry Well
WELL'S STATIC WATER LEVEL: 25 ft. 3-25-13
☒ below land surface, measured on (mo-day-yr)
☐ above land surface, measured on (mo-day-yr)
Pump test data: Well water was ft.
after hours pumping gpm
Well water was ft.
after hours pumping gpm
Estimated Yield: 40 gpm
Bore Hole Diameter: 12 in. to 58 ft. and
..... in. to ft.

5 Latitude:

..... (decimal degrees)

Longitude: (decimal degrees)

Datum: ☐ WGS 84 ☐ NAD 83 ☐ NAD 27

Source for Latitude/Longitude:

☐ GPS (unit make/model:)

(WAAS enabled? ☐ Yes ☐ No)

☐ Land Survey ☐ Topographic Map

☐ Online Mapper:

6 Elevation:

..... ft. ☐ Ground Level ☐ TOC

Source: ☐ Land Survey ☐ GPS ☐ Topographic Map

☐ Other

7 WELL WATER TO BE USED AS:

1. Domestic:
 - ☐ Household
 - ☒ Lawn & Garden
 - ☐ Livestock
2. ☐ Irrigation
3. ☐ Feedlot
4. ☐ Industrial
5. ☐ Public Water Supply: well ID
6. ☐ Dewatering: how many wells?
7. ☐ Aquifer Recharge: well ID
8. ☐ Monitoring: well ID
9. Environmental Remediation: well ID
 - ☐ Air Sparge ☐ Soil Vapor Extraction
 - ☐ Recovery ☐ Injection
10. ☐ Oil Field Water Supply: lease
11. Test Hole: well ID
 - ☐ Cased ☐ Uncased ☐ Geotechnical
12. Geothermal: how many bores?
 - a) Closed Loop ☐ Horizontal ☐ Vertical
 - b) Open Loop ☐ Surface Discharge ☐ Inj. of Water
13. ☐ Other (specify):

Was a chemical/bacteriological sample submitted to KDHE? ☐ Yes ☒ No If yes, date sample was submitted:

Water well disinfected? ☒ Yes ☐ No

8 TYPE OF CASING USED:

☐ Steel ☒ PVC ☐ Other CASING JOINTS: ☒ Glued ☐ Clamped ☐ Welded ☐ Threaded
Casing diameter in. to ft., Diameter in. to ft., Diameter in. to ft.
Casing height above land surface in. Weight 2.4 lbs./ft. Wall thickness or gauge No. Neopsi

TYPE OF SCREEN OR PERFORATION MATERIAL:

- ☐ Steel ☐ Stainless Steel ☐ Fiberglass ☒ PVC ☐ Other (Specify)
☐ Brass ☐ Galvanized Steel ☐ Concrete tile ☐ None used (open hole)

SCREEN OR PERFORATION OPENINGS ARE:

- ☐ Continuous Slot ☒ Mill Slot ☐ Gauze Wrapped ☐ Torch Cut ☐ Drilled Holes ☐ Other (Specify)
☐ Louvered Shutter ☐ Key Punched ☐ Wire Wrapped ☐ Saw Cut ☐ None (Open Hole)

SCREEN-PERFORATED INTERVALS: From 48 ft. to 58 ft., From ft. to ft., From ft. to ft.

GRAVEL PACK INTERVALS: From 25 ft. to 58 ft., From ft. to ft., From ft. to ft.

9 GROUT MATERIAL:

☐ Neat cement ☐ Cement grout ☒ Bentonite ☐ Other

Grout Intervals: From 3 ft. to 25 ft., From ft. to ft., From ft. to ft.

Nearest source of possible contamination:

- ☐ Septic Tank ☐ Lateral Lines ☐ Pit Privy ☐ Livestock Pens ☐ Insecticide Storage
☐ Sewer Lines ☐ Cess Pool ☐ Sewage Lagoon ☐ Fuel Storage ☐ Abandoned Water Well
☒ Watertight Sewer Lines ☐ Seepage Pit ☐ Feedyard ☐ Fertilizer Storage ☐ Oil Well/Gas Well
☐ Other (Specify)

Direction from well? West Distance from well? 17'

10 FROM TO LITHOLOGIC LOG FROM TO LITHO. LOG (cont.) or PLUGGING INTERVALS

0	3	Top Soil			
3	25	Clay			
25	33	Fine Sand			
33	40	Clay			
40	58	Med Sand			

Notes:

11 CONTRACTOR'S OR LANDOWNER'S CERTIFICATION: This water well was ☒ constructed, ☐ reconstructed, or ☐ plugged under my jurisdiction and was completed on (mo-day-yr) 3-25-13 and this record is true to the best of my knowledge and belief.
Kansas Water Well Contractor's License No. 7-10 This Water Well Record was completed on (mo-day-yr) 5-1-13
under the business name of Werner Drilling Inc. (Werner)

INSTRUCTIONS: Send one copy to WATER WELL OWNER and retain one copy for your records. Submit fee of \$5.00 for each constructed well along with one (white) copy to Kansas Department of Health and Environment, Bureau of Water, Geology Section, 1000 SW Jackson St., Suite 420, Topeka, Kansas 66612-1367. Telephone (785) 296-3565.

Visit us at <http://www.kdheks.gov/waterwell/index.html>

KSA 82a-1212

Revised 9/10/2012