


WATER WELL RECORD Form WWC-5 KSA 82a-1212

1 LOCATION OF WATER WELL: Sedgwick	FRACTION NW 1/4 NE 1/4 SE 1/4	SECTION NUMBER 32	TOWNSHIP NUMBER T 26 S	RANGE NUMBER R 1W E/W
--	---	-----------------------------	----------------------------------	---------------------------------

Distance and direction from nearest town or city street address of well if located within city?
3333 Brush Creek Wichita, Kansas

2 WATER WELL OWNER: ROBL CONSTRUCTION RR#,ST. ADDRESS,BOX #: 5842 N. 21st N. CITY, STATE: Wichita, Kansas	Board of Agriculture, Division of Water Resource Application Number:
ZIP CODE:	

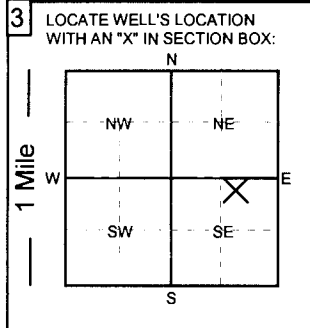

4 DEPTH OF COMPLETED WELL: 65 ft.	ELEVATION:
Depth of groundwater Encountered: _____ ft.	_____ ft.
WELL'S STATIC WATER LEVEL 25 FT. BELOW LAND SURFACE MEASURED ON 3/17/14	
Pump test data: Well water was _____ ft. after _____ hours of pumping @ _____ gpm Est. Yield: _____ gpm Well water was _____ ft. after _____ hours of pumping @ _____ gpm Bore Hole Diameter 12 in. to 65 ft. and _____ in. to _____ ft.	
WELL WATER TO BE USED AS:	
1. Domestic 2. Irrigation 3. Feedlot 4. Industrial 5. Public water supply 6. Oil field water supply 7. <u>Lawn and garden only</u> 8. Air conditioning 9. Dewatering 10. Monitoring well 11. Injection well 12. Other (Specify below)	
Was a chemical/bacteriological sample submitted to Department? YES <u>NO</u> ; If yes, what mo/day/yr was sample submitted	
Was Water Well Disinfected? <u>YES</u> NO	

5 TYPE OF CASING USED:	CASING JOINTS: <u>Glued</u> Threaded Welded Clamped
1. Steel 2. <u>PVC</u> 3. RPM (SR) 4. ABS 5. Wrought Iron 6. Asbestos-Cement 7. Fiberglass 8. Concrete tile 9. Other (Specify below)	
Blank casing diameter 5 in. to 45 ft., Dia.	in. to _____ ft., Dia.
Casing height above land surface: 12 in.,	Weight: 2.35 lbs. / ft. Wall thickness or gauge No. .214
TYPE OF SCREEN OR PERFORATION MATERIAL:	
1. Steel 2. Brass 3. Stainless Steel 4. Galvanized 5. Fiberglass 6. Concrete Tile 7. <u>PVC</u> 8. RMP (SR) 9. ABS 10. Asbestos-Cement 11. Other (specify) 12. None used (open hole)	
SCREEN OR PERFORATION OPENINGS ARE:	
1. Continuous slot 2. Louvered shutter 3. Mill slot 4. Key punched 5. Gauzed wrapped 6. Wire wrapped 7. Torch cut 8. <u>Saw cut</u> 9. Drilled holes 10. Other (specify) 11. None (open hole)	
SCREEN - PERFORATION INTERVAL	From 45 ft. to 65 ft.,
GRAVEL PACK INTERVALS:	From 24 ft. to 65 ft.,

6 GROUT MATERIALS:	1. Neat cement 2. Cement Grout 3. Bentonite Other bentonite hole plug
Grout Intervals: From 4 ft. to 24 ft.,	From _____ ft. to _____ ft., From _____ ft. to _____ ft.
What is the nearest source of possible contamination:	
1. <u>Watertight sewer line</u> 2. Sewer lines 3. Septic tank 4. Lateral lines 5. Cess Pool 6. Seepage pit 7. Pit privy 8. Sewage lagoon 9. Feed yard 10. Livestock pens 11. Fuel storage 12. Fertilizer storage 13. Insecticide storage 14. Abandon water well 15. Oil well/Gas well 16. Other (specify below)	
Direction from well? North	How many feet? 10 ft. plus

From	To	LITHOLOGIC LOG	From	To	LITHOLOGIC LOG
0	3	topsoil			
3	20	clay			
20	40	fine sand			
40	65	medium sand			

7 Contractor's or Landowner's Certification: This water well was 1. <u>constructed</u> 2. reconstructed or 3. plugged under my jurisdiction and was completed on (mo/day/year) 3/17/2014	and this record is true to the best of my knowledge and belief.
Kansas Water Well Contractor's License No. 236	This water well record was completed on (mo/day/year) 3/19/2014
under the business name of Harp Well and Pump Service	by (signature) Todd S. Harp