


WATER WELL RECORD Form WWC-5 KSA 82a-1212

1	LOCATION OF WATER WELL: <b>Sedgwick</b>	FRACTION <b>NE 1/4 SW 1/4 SE 1/4</b>	SECTION NUMBER <b>29</b>	TOWNSHIP NUMBER <b>T 26 S</b>	RANGE NUMBER <b>R 1W E/W</b>
---	--	---	-----------------------------	----------------------------------	---------------------------------

Distance and direction from nearest town or city street address of well if located within city?  
**3855 N. Lily Ct. Maize, Kansas**

2	WATER WELL OWNER: <b>LOVE, Mike Construction</b>	RR#,ST. ADDRESS,BOX #: <b>P.O. Box 7</b>	CITY, STATE: <b>Valley Center, Kansas</b>	ZIP CODE: Application Number:	Board of Agriculture, Division of Water Resource
---	---	---	--	----------------------------------	--

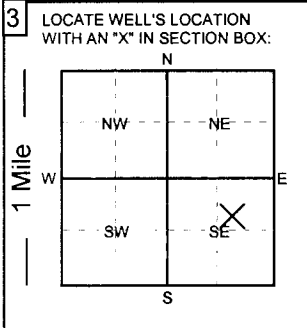

4	DEPTH OF COMPLETED WELL: <b>52</b> ft.	ELEVATION:
Depth of groundwater Encountered: _____ ft.		
WELL'S STATIC WATER LEVEL <b>14</b> FT. BELOW LAND SURFACE MEASURED ON <b>5/16/14</b>		
Pump test data:	Well water was _____ ft. after _____ hours of pumping @ _____ gpm	
Est. Yield:	Well water was _____ ft. after _____ hours of pumping @ _____ gpm	
Bore Hole Diameter	<b>12</b> in. to <b>52</b> ft. and _____ in. to _____ ft.	
WELL WATER TO BE USED AS:		
1. Domestic	3. Feedlot	5. Public water supply
2. Irrigation	4. Industrial	6. Oil field water supply
7. <b>Lawn and garden only</b>	8. Air conditioning	9. Dewatering
10. Monitoring well	11. Injection well	12. Other (Specify below)
Was a chemical/bacteriological sample submitted to Department? <b>NO</b> ; If yes, what mo/day/yr was sample submitted _____		
Was Water Well Disinfected? <b>YES</b> <b>NO</b>		

5	TYPE OF CASING USED:	5. Wrought Iron	7. Fiberglass	9. Other (Specify below)	CASING JOINTS: <b>Glued</b>	Threaded
1. Steel	3. RPM (SR)	6. Asbestos-Cement	8. Concrete tile	SDR-26	Welded	Clamped
2. <b>PVC</b>	4. ABS					
Blank casing diameter	<b>5</b> in. to <b>37</b> ft., Dia.	in. to ft., Dia.	in. to ft., Dia.	in. to ft., Dia.	in. to ft., Dia.	
Casing height above land surface:	<b>12</b> in.,	Weight:	<b>2.35</b> lbs. / ft.	Wall thickness or gauge No.	<b>.214</b>	
TYPE OF SCREEN OR PERFORATION MATERIAL:						
1. Steel	3. Stainless Steel	5. Fiberglass	7. <b>PVC</b>	9. ABS	11. Other (specify)	
2. Brass	4. Galvanized	6. Concrete Tile	8. RMP (SR)	10. Asbestos-Cement	12. None used (open hole)	
SCREEN OR PERFORATION OPENINGS ARE:						
1. <b>Continuous slot</b>	3. Mill slot	5. Gauzed wrapped	7. Torch cut	9. Drilled holes	11. None (open hole)	
2. Louvered shutter	4. Key punched	6. Wire wrapped	8. <b>Saw cut</b>	10. Other (specify)		
SCREEN - PERFORATION INTERVAL	From <b>37</b> ft. to <b>52</b> ft.,	From _____ ft. to _____ ft.,	From _____ ft. to _____ ft.,	From _____ ft. to _____ ft.,	From _____ ft. to _____ ft.,	From _____ ft. to _____ ft.,
GRAVEL PACK INTERVALS:	From <b>24</b> ft. to <b>52</b> ft.,	From _____ ft. to _____ ft.,	From _____ ft. to _____ ft.,	From _____ ft. to _____ ft.,	From _____ ft. to _____ ft.,	From _____ ft. to _____ ft.,

6	GROUT MATERIALS:	1. Neat cement	2. Cement Grout	3. Bentonite	Other <b>bentonite hole plug</b>
Grout intervals:	From <b>4</b> ft. to <b>24</b> ft.,	From _____ ft. to _____ ft.,	From _____ ft. to _____ ft.,	From _____ ft. to _____ ft.,	From _____ ft. to _____ ft.,
What is the nearest source of possible contamination:					
1. <b>Watertight sewer line</b>	4. Lateral lines	7. Pit privy	10. Livestock pens	13. Insecticide storage	15. Oil well/Gas well
2. Sewer lines	5. Cess Pool	8. Sewage lagoon	11. Fuel storage	14. Abandon water well	16. Other (specify below)
3. <b>Watertight sewer line</b>	6. Seepage pit	9. Feed yard	12. Fertilizer storage		
Direction from well? <b>East</b>					How many feet? <b>10 ft. plus</b>

From	To	LITHOLOGIC LOG	From	To	LITHOLOGIC LOG
0	3	topsoil			
5	10	sandy clay			
10	20	fine sand			
20	52	medium sand			

7 Contractor's or Landowner's Certification: This water well was 1. **constructed** 2. reconstructed or 3. plugged under my jurisdiction and was completed on (mo/day/year) **5/16/14** and this record is true to the best of my knowledge and belief.

Kansas Water Well Contractor's License No. **236** This water well record was completed on (mo/day/year) **5/19/14**

under the business name of **Harp Well and Pump Service** by (signature) **Todd S. Harp**