


WATER WELL RECORD Form WWC-5 KSA 82a-1212

1 LOCATION OF WATER WELL: Sedgwick FRACTION: NE 1/4 SW 1/4 SE 1/4 SECTION NUMBER: 29 TOWNSHIP NUMBER: T 26 S RANGE NUMBER: R 1W E/W

Distance and direction from nearest town or city street address of well if located within city? 3859 N. Lily Ct. Maize, Kansas

2 WATER WELL OWNER: LOVE, Mike Construction RR#,ST. ADDRESS,BOX #: P.O. Box 7 CITY, STATE: Valley Center, Kansas ZIP CODE: Board of Agriculture, Division of Water Resource Application Number:

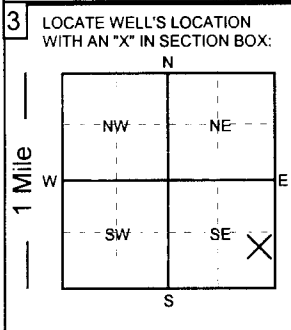

3 LOCATE WELL'S LOCATION WITH AN 'X' IN SECTION BOX: 4 DEPTH OF COMPLETED WELL: 52 ft. ELEVATION: WELL'S STATIC WATER LEVEL: 14 FT. BELOW LAND SURFACE MEASURED ON 5/16/14

5 TYPE OF CASING USED: 1. Steel 2. PVC 3. RPM (SR) 4. ABS 5. Wrought Iron 6. Asbestos-Cement 7. Fiberglass 8. Concrete tile 9. Other (Specify below) CASING JOINTS: Glued, Threaded, Welded, Clamped

6 GROUT MATERIALS: 1. Neat cement 2. Cement Grout 3. Bentonite Other: bentonite hole plug Grout Intervals: From 4 ft. to 24 ft.

LITHOLOGIC LOG table with columns: From, To, LITHOLOGIC LOG. Entries: 0-3 topsoil, 3-5 sandy clay, 5-10 fine sand, 10-20 medium sand.

7 Contractor's or Landowner's Certification: This water well was 1. constructed 2. reconstructed or 3. plugged under my jurisdiction and was completed on (mo/day/year) 5/16/14 and this record is true to the best of my knowledge and belief.