


SE NW NE SW

1 LOCATION OF WATER WELL: Sedgwick	FRACTION NE 1/4 NW 1/4 SW 1/4	Section Number 33	Township Number T 26 S	Range Number R 1W E/W
--	---	-----------------------------	----------------------------------	---------------------------------

Distance and direction from nearest town or city street address of well if located within city?

3317 N. Forrest Ridge Wichita, Kansas

WATER WELL OWNER: SHADOW LAKES	Board of Agriculture, Division of Water Resource
RR#, ST. ADDRESS, BOX #: 3317 N. Forrest Ridge	Application Number:
CITY, STATE, ZIP CODE: Wichita, Kansas	

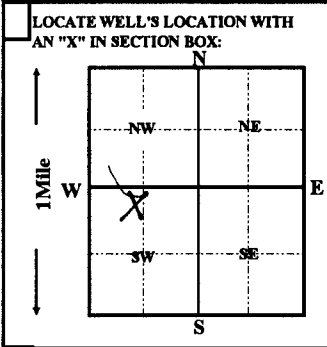

4 DEPTH OF COMPLETED WELL 100 ft.	ELEVATION:
Depth(s) groundwater Encountered 1 ft.	2 ft.
WELL'S STATIC WATER LEVEL 30 FT. BELOW LAND SURFACE MEASURED ON	09/08/1998
Pump test data:	Well water was
Est. Yield	gpm: Well water was
Bore Hole Diameter	12 in. to 100 ft.
WELL WATER TO BE USED AS:	5 Public water supply
1 Domestic	3 Feedlot
2 Irrigation	4 Industrial
Was a chemical/bacteriological sample submitted to Department? Yes	No X ; If yes, mo/day/yr sample was submitted
Water Well Disinfected? Yes X	No

5 TYPE OF CASING USED:	5 Wrought iron	8 Concrete tile	CASING JOINTS:	Glued X Clamped
1 Steel	3 RMP (SR)	6 Asbestos-Cement	9 Other (Specify below)	Welded
2 PVC	4 ABS	7 Fiberglass	SDR-26	Threaded
Blank casing Diameter	5 in. to 70 ft., Dia	weight	2.35 lbs. / ft.	Wall thickness or gauge No. .214
Casing height above land surface	12 in.			
TYPE OF SCREEN OR PERFORATION MATERIAL:	5 Fiberglass	7 PVC	10 Asbestos-cement	
1 Steel	3 Stainless Steel	8 RMP (SR)	11 other (specify)	
2 Brass	4 Galvanized steel	9 ABS	12 None used (open hole)	
SCREEN OR PERFORATION OPENING ARE:	5 Gauzed wrapped	8 Saw cut	11 None (open hole)	
1 Continuous slot	3 Mill slot	9 Drilled holes		
2 Louvered shutter	4 Key punched	10 Other (specify)		
SCREEN-PERFORATION INTERVALS:	from 70 ft. to 100 ft., From	ft. to	ft.	
GRAVEL PACK INTERVALS:	from 24 ft. to 100 ft., From	ft. to	ft.	

6 GROUT MATERIAL:	1 Neat cement	2 Cement grout	3 Bentonite	4 Other bentonite hole plug
Grout Intervals: From	4 ft. to 24 ft. From	ft. to	ft. From	ft. to
What is the nearest source of possible contamination:	1 Septic tank	4 Lateral lines	7 Pit privy	10 Livestock pens
	2 Sewer lines	5 Cess pool	8 Sewage lagoon	11 Fuel storage
	3 Watertight sewer lines	6 Seepage pit	9 Feedyard	12 Fertilizer storage
				13 Insecticide storage
Direction from well?	East	How many feet?	15	

FROM	TO	LITHOLOGIC LOG	FROM	TO	PLUGGING INTERVALS
0	4	topsoil			
4	10	fine sand			
10	24	clay			
24	35	coarse dirty sand			
35	38	clay			
38	80	medium sand			
80	95	coarse sand			
95	100	fine sand			

7 CONTRACTOR'S OR LANDOWNER'S CERTIFICATION: This water well was (1) constructed, (2) reconstructed, or (3) plugged under my jurisdiction and was completed on (mo/day/year) 09/08/1998 and this record is true to the best of my knowledge and belief. Kansas Water Well Contractor's License No. 236 This Water Well Record was completed on (mo/day/yr) 09/11/98 Under the business name of Harp Well & Pump Service, Inc. by (signature) Todd S. Harp
--