


WATER WELL RECORD Form WWC-5 KSA 82a-1212

1 LOCATION OF WATER WELL: Sedgwick	FRACTION SW 1/4 NE 1/4 NE 1/4	SECTION NUMBER 33	TOWNSHIP NUMBER T 26 S	RANGE NUMBER R 1W E/W
--	---	-----------------------------	----------------------------------	---------------------------------

Distance and direction from nearest town or city street address of well if located within city?
3602 Beach Club Wichita, Kansas

2 WATER WELL OWNER: ROBL CONSTRUCTION	Board of Agriculture, Division of Water Resource
RR#,ST. ADDRESS,BOX #: 5842 W. 21st N.	Application Number:
CITY, STATE: Wichita, Kansas	ZIP CODE:

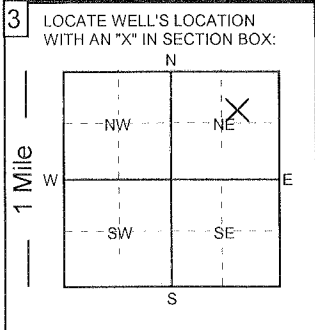

4 DEPTH OF COMPLETED WELL: 45 ft.	ELEVATION:
Depth of groundwater Encountered: _____ ft.	
WELL'S STATIC WATER LEVEL 14 FT. BELOW LAND SURFACE MEASURED ON 10/13/15	
Pump test data:	Well water was _____ ft. after _____ hours of pumping @ _____ gpm
Est. Yield: _____ gpm	Well water was _____ ft. after _____ hours of pumping @ _____ gpm
Bore Hole Diameter 12 in.	to 45 ft. and _____ in. to _____ ft.
WELL WATER TO BE USED AS:	
1. Domestic	3. Feedlot
5. Public water supply	7. <u>Lawn and garden only</u>
2. Irrigation	4. Industrial
6. Oil field water supply	8. Air conditioning
9. Dewatering	11. Injection well
12. Other (Specify below)	
Was a chemical/bacteriological sample submitted to Department? YES <u>NO</u> ; If yes, what mo/day/yr was sample submitted	
Was Water Well Disinfected? <u>YES</u> NO	

5 TYPE OF CASING USED:	CASING JOINTS: <u>Glued</u> Threaded
1. Steel	3. RPM (SR)
<u>2. PVC</u>	4. ABS
5. Wrought Iron	7. Fiberglass
6. Asbestos-Cement	8. Concrete tile
9. Other (Specify below)	SDR-26
Blank casing diameter	5 in. to 35 ft., Dia. in. to _____ ft., Dia. in. to _____ ft.
Casing height above land surface:	12 in., Weight: 2.35 lbs. / ft. Wall thickness or gauge No. .214
TYPE OF SCREEN OR PERFORATION MATERIAL:	
1. Steel	3. Stainless Steel
5. Fiberglass	<u>7. PVC</u>
9. ABS	11. Other (specify)
2. Brass	4. Galvanized
6. Concrete Tile	8. RMP (SR)
10. Asbestos-Cement	12. None used (open hole)
SCREEN OR PERFORATION OPENINGS ARE:	
1. Continuous slot	3. Mill slot
5. Gauzed wrapped	7. Torch cut
9. Drilled holes	11. None (open hole)
2. Louvered shutter	4. Key punched
6. Wire wrapped	<u>8. Saw cut</u>
10. Other (specify)	
SCREEN - PERFORATION INTERVAL	
From 35 ft. to 45 ft.,	From _____ ft. to _____ ft.
GRAVEL PACK INTERVALS:	From 24 ft. to 45 ft.,
From _____ ft. to _____ ft.,	From _____ ft. to _____ ft.

6 GROUT MATERIALS:	Other bentonite hole plug
1. Neat cement	2. Cement Grout
3. Bentonite	
Grout Intervals: From 4 ft. to 24 ft.,	From _____ ft. to _____ ft., From _____ ft. to _____ ft.
What is the nearest source of possible contamination:	
1. Septic tank	4. Lateral lines
7. Pit privy	10. Livestock pens
13. Insecticide storage	15. Oil well/Gas well
2. Sewer lines	5. Cess Pool
8. Sewage lagoon	11. Fuel storage
14. Abandon water well	16. Other (specify below)
<u>3. Watertight sewer line</u>	6. Seepage pit
9. Feed yard	12. Fertilizer storage
Direction from well? West	How many feet? 50 ft. plus

From	To	LITHOLOGIC LOG	From	To	LITHOLOGIC LOG
0	3	topsoil			
3	10	clay			
10	25	fine sand			
25	35	clay			
35	45	medium sand			

7 Contractor's or Landowner's Certification: This water well was 1. <u>constructed</u> 2. reconstructed or 3. plugged under my jurisdiction and was completed on (mo/day/year) 10-13-2015 and this record is true to the best of my knowledge and belief.	This water well record was completed on (mo/day/year) 10-14-2015
Kansas Water Well Contractor's License No. 236	under the business name of Harp Well and Pump Service
by (signature) Todd S. Harp	