


WATER WELL RECORD Form WWC-5 KSA 82a-1212

1 LOCATION OF WATER WELL: Sedgwick FRACTION NW 1/4 NW 1/4 NW 1/4 SECTION NUMBER 33 TOWNSHIP NUMBER T 26 S RANGE NUMBER R 1W E/W

Distance and direction from nearest town or city street address of well if located within city? 8667 W. 37th N. Ct. Wichita, Kansas

2 WATER WELL OWNER: WIENS, Jeff Board of Agriculture, Division of Water Resource RR#,ST. ADDRESS,BOX #: 7818 W. Meadow Park Ct. CITY, STATE: Wichita, Kansas ZIP CODE: Application Number:

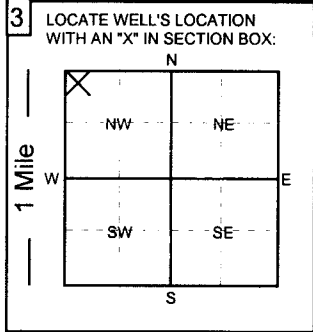

3 LOCATE WELL'S LOCATION WITH AN 'X' IN SECTION BOX: 4 DEPTH OF COMPLETED WELL: 70 ft. ELEVATION: WELL'S STATIC WATER LEVEL 15 FT. BELOW LAND SURFACE MEASURED ON 1/11/16

5 TYPE OF CASING USED: 1. Steel 2. PVC 3. RPM (SR) 4. ABS 5. Wrought Iron 6. Asbestos-Cement 7. Fiberglass 8. Concrete tile 9. Other (Specify below) CASING JOINTS: Glued Threaded SDR-26 Welded Clamped

6 GROUT MATERIALS: 1. Neat cement 2. Cement Grout 3. Bentonite Other bentonite hole plug Grout Intervals: From 4 ft. to 24 ft.

LITHOLOGIC LOG table with columns for From, To, and Lithologic Log. Entries include topsoil (0-3), fine sand (3-20), medium sand (20-40), and medium to coarse sand (40-70).

7 Contractor's or Landowner's Certification: This water well was 1. constructed 2. reconstructed or 3. plugged under my jurisdiction and was completed on (mo/day/year) 1/11/2016 and this record is true to the best of my knowledge and belief.

Kansas Water Well Contractor's License No. 236 This water well record was completed on (mo/day/year) 1/20/16 under the business name of Harp Well and Pump Service by (signature) Todd S. Harp