

WATER WELL RECORD Form WWC-5

Original Record Correction Change in Well Use


Division of Water Resources App. No.

Well ID

Well ID

1 LOCATION OF WATER WELL: County: SEDGWICK Fraction SE 1/4 NE 1/4 SW 1/4 SE 1/4 Section Number 29 Township Number T 26 S Range Number R 1 E W

2 WELL OWNER: Last Name: Business: TW CUSTOM HOMES Address: 9330 WEST MOSS ROSE STREET City: MAIZE State: KS ZIP: 67101 Street or Rural Address where well is located: 3904 NORTH LILY CIR., MAIZE, KS, 67101

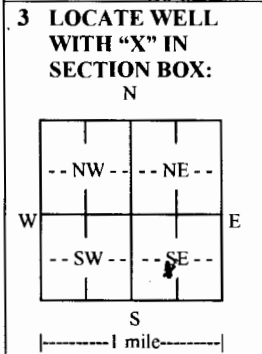

4 DEPTH OF COMPLETED WELL: 60 ft. Depth(s) Groundwater Encountered: 1) ... ft. 2) ... ft. 3) ... ft., or 4) Dry Well WELL'S STATIC WATER LEVEL: 30 ft. below land surface, measured on (mo-day-yr) 5/29/2018

5 Latitude: ... (decimal degrees) Longitude: ... (decimal degrees) Horizontal Datum: WGS 84 NAD 83 NAD 27 Source for Latitude/Longitude: GPS (unit make/model: ... (WAAS enabled? Yes No) Land Survey Topographic Map Online Mapper:

7 WELL WATER TO BE USED AS: 1. Domestic: Household Lawn & Garden Livestock Irrigation Feedlot Industrial 2. Public Water Supply: well ID 3. Dewatering: how many wells? 4. Aquifer Recharge: well ID 5. Monitoring: well ID 6. Environmental Remediation: well ID Air Sparge Soil Vapor Extraction Recovery Injection 7. Oil Field Water Supply: lease 8. Test Hole: well ID Cased Uncased Geotechnical 9. Geothermal: how many bores? a) Closed Loop Horizontal Vertical b) Open Loop Surface Discharge Inj. of Water 10. Other (specify):

Was a chemical/bacteriological sample submitted to KDHE? Yes No If yes, date sample was submitted: Water well disinfected? Yes No

8 TYPE OF CASING USED: Steel PVC Other CASING JOINTS: Glued Clamped Welded Threaded Casing diameter 5 in. to 60 ft. Diameter in. to ft. Diameter in. to ft. Casing height above land surface 14 in. Weight lbs./ft. Wall thickness or gauge No. SDR: 26

TYPE OF SCREEN OR PERFORATION MATERIAL: Steel Stainless Steel Fiberglass PVC Other (Specify) Brass Galvanized Steel Concrete tile None used (open hole) SCREEN OR PERFORATION OPENINGS ARE: Continuous Slot Mill Slot Gauze Wrapped Torch Cut Drilled Holes Other (Specify) Louvered Shutter Key Punched Wire Wrapped Saw Cut None (Open Hole) SCREEN-PERFORATED INTERVALS: From 40 ft. to 60 ft. From ft. to ft. From ft. to ft. GRAVEL PACK INTERVALS: From 23 ft. to 60 ft. From ft. to ft. From ft. to ft.

9 GROUT MATERIAL: Neat cement Cement grout Bentonite Other Grout Intervals: From 3 ft. to 23 ft. From ft. to ft. From ft. to ft.

Nearest source of possible contamination: Septic Tank Lateral Lines Pit Privy Livestock Pens Insecticide Storage Sewer Lines Cess Pool Sewage Lagoon Fuel Storage Abandoned Water Well Watertight Sewer Lines Seepage Pit Feedyard Fertilizer Storage Oil Well/Gas Well Other (Specify) Direction from well? WEST Distance from well? 80+ ft.

Table with columns: 10 FROM, TO, LITHOLOGIC LOG, FROM, TO, LITHO. LOG (cont.) or PLUGGING INTERVALS. Rows: 0-1 TOP SOIL, 1-10 CLAY, 10-60 MED GRAVEL. Includes a Notes section.

11 CONTRACTOR'S OR LANDOWNER'S CERTIFICATION: This water well was constructed, reconstructed, or plugged under my jurisdiction and was completed on (mo-day-year) 5/29/2018 and this record is true to the best of my knowledge and belief. Kansas Water Well Contractor's License No. 884 This Water Well Record was completed on (mo-day-year) 6/27/2018 under the business name of WENINGER DRILLING, LLC Signature: MARSHA KBYKROWISKI