


WATER WELL RECORD Form WWC-5 KSA 82a-1212

1 LOCATION OF WATER WELL: <b>Sedgwick</b>	FRACTION <b>SE 1/4 NW 1/4 NE 1/4</b>	SECTION NUMBER <b>27</b>	TOWNSHIP NUMBER <b>T 26 S</b>	RANGE NUMBER <b>R 1W E/W</b>
--	---	-----------------------------	----------------------------------	---------------------------------

Distance and direction from nearest town or city street address of well if located within city?

**6006 W. Kollmeyer Wichita, Kansas**

2 WATER WELL OWNER: RR#,ST. ADDRESS,BOX #: CITY, STATE:	<b>ROBL CONSTRUCTION</b> <b>5842 W. 21st N.</b> <b>Wichita, Kansas</b>	Board of Agriculture, Division of Water Resource Application Number:
		ZIP CODE: <b>67025</b>

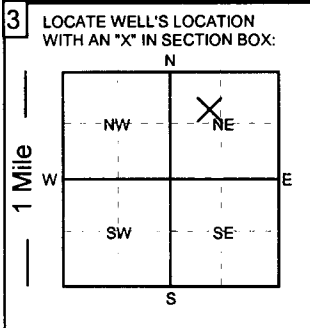

4 DEPTH OF COMPLETED WELL:	<b>40</b> ft.	ELEVATION:	
Depth of groundwater Encountered:			
WELL'S STATIC WATER LEVEL	<b>12</b> FT. BELOW LAND SURFACE MEASURED ON	<b>7/13/19</b>	
Pump test data:	Well water was	ft. after	hours of pumping @
Est. Yield:	gpm	Well water was	ft. after
Bore Hole Diameter	<b>12</b> in.	to <b>40</b> ft.	and in. to ft.
WELL WATER TO BE USED AS:	1. Domestic    3. Feedlot    5. Public water supply <b>7. Lawn and garden only</b> 9. Dewatering    11. Injection well 2. Irrigation    4. Industrial    6. Oil field water supply    8. Air conditioning    10. Monitoring well    12. Other (Specify below)		
Was a chemical/bacteriological sample submitted to Department?	YES <input type="checkbox"/> <b>NO</b> <input checked="" type="checkbox"/> ; If yes, what mo/day/yr was sample submitted		
Was Water Well Disinfected?	<b>YES</b> <input checked="" type="checkbox"/> <b>NO</b> <input type="checkbox"/>		

5 TYPE OF CASING USED:	1. Steel	3. RPM (SR)	5. Wrought Iron	7. Fiberglass	9. Other (Specify below)	CASING JOINTS:	<b>Glued</b> <input checked="" type="checkbox"/>	Threaded
	<b>2. PVC</b> <input checked="" type="checkbox"/>	4. ABS	6. Asbestos-Cement	8. Concrete tile			Welded	Clamped
Blank casing diameter	<b>5</b> in.	to <b>30</b> ft.,	Dia.	in.	to	ft.,	Dia.	in. to ft.
Casing height above land surface:	<b>12</b> in.,	Weight:	<b>2.35</b> lbs. / ft.	Wall thickness or gauge No.	<b>.214</b>			
TYPE OF SCREEN OR PERFORATION MATERIAL:	1. Steel	3. Stainless Steel	5. Fiberglass	<b>7. PVC</b> <input checked="" type="checkbox"/>	9. ABS	11. Other (specify)		
	2. Brass	4. Galvanized	6. Concrete Tile	8. RMP (SR)	10. Asbestos-Cement	12. None used (open hole)		
SCREEN OR PERFORATION OPENINGS ARE:	1. Continuous slot	3. Mill slot	5. Gauzed wrapped	7. Torch cut	9. Drilled holes	11. None ( open hole)		
	2. Louvered shutter	4. Key punched	6. Wire wrapped	<b>8. Saw cut</b> <input checked="" type="checkbox"/>	10. Other (specify)			
SCREEN - PERFORATION INTERVAL	From	<b>30</b> ft.	to	<b>40</b> ft.,	From	ft.	to	ft.
		ft.		ft.,	From	ft.		ft.
GRAVEL PACK INTERVALS:	From	<b>24</b> ft.	to	<b>40</b> ft.,	From	ft.	to	ft.
		ft.		ft.,	From	ft.		ft.

6 GROUT MATERIALS:	1. Neat cement	2. Cement Grout	3. Bentonite	Other	<b>bentonite hole plug</b>			
Grout Intervals:	From	ft.	to	ft.,	From	<b>4</b> ft.	to	<b>24</b> ft.
What is the nearest source of possible contamination:	1. Septic tank	4. Lateral lines	7. Pit privy	10. Livestock pens	13. Insecticide storage	15. Oil well/Gas well		
	2. Sewer lines	5. Cess Pool	8. Sewage lagoon	11. Fuel storage	14. Abandon water well	16. Other (specify below)		
	<b>3. Watertight sewer line</b> <input checked="" type="checkbox"/>	6. Seepage pit	9. Feed yard	12. Fertilizer storage				
Direction from well?	<b>South</b>							
	How many feet? <b>80 ft. plus</b>							

From	To	LITHOLOGIC LOG	From	To	LITHOLOGIC LOG
0	3	topsoil			
3	26	fine sand			
26	40	medium sand			

7 Contractor's or Landowner's Certification: This water well was 1. **constructed** 2. reconstructed or 3. plugged under my jurisdiction and was completed on (mo/day/year) **7/13/19** and this record is true to the best of my knowledge and belief.

Kansas Water Well Contractor's License No. **236** This water well record was completed on (mo/day/year) **7/15/19**

under the business name of **Harp Well and Pump Service** by (signature) **Todd S. Harp**