


WATER WELL RECORD Form WWC-5 KSA 82a-1212

1 LOCATION OF WATER WELL: Sedgwick FRACTION SE 1/4 NE 1/4 NW 1/4 SECTION NUMBER 27 TOWNSHIP NUMBER T 26 S RANGE NUMBER R 1W E/W

Distance and direction from nearest town or city street address of well if located within city? 4502 N. Ridgeport Wichita, Kansas

2 WATER WELL OWNER: MURREY, Justin RR#,ST. ADDRESS,BOX #: 4502 N. Ridgeport CITY, STATE: Wichita, Kansas Board of Agriculture, Division of Water Resource ZIP CODE: 67205 Application Number:

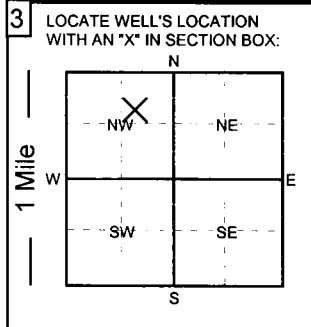

3 LOCATE WELL'S LOCATION WITH AN "X" IN SECTION BOX: 4 DEPTH OF COMPLETED WELL: 35 ft. ELEVATION: WELL'S STATIC WATER LEVEL 15 FT. BELOW LAND SURFACE MEASURED ON 5/7/20 Pump test data: Well water was ft. after hours of pumping @ gpm

5 TYPE OF CASING USED: 1. Steel 2. PVC 3. RPM (SR) 4. ABS 5. Wrought Iron 6. Asbestos-Cement 7. Fiberglass 8. Concrete tile 9. Other (Specify below) CASING JOINTS: Glued Threaded Welded Clamped

6 GROUT MATERIALS: 1. Neat cement 2. Cement Grout 3. Bentonite Other bentonite hole plug Grout Intervals: From 4 ft. to 24 ft. What is the nearest source of possible contamination: 3. Watertight sewer line

LITHOLOGIC LOG table with columns From, To, and description. Entries: 0-3 topsoil, 3-11 sandy clay, 11-27 fine sand, 27-35 medium sand.

7 Contractor's or Landowner's Certification: This water well was 1. constructed 2. reconstructed or 3. plugged under my jurisdiction and was completed on (mo/day/year) 5/7/2020 and this record is true to the best of my knowledge and belief.

Todd S. Harp