

Correction

WATER WELL RECORD Form WWC-5


Division of Water Resources App. No.

Well ID

Original Record Correction Change in Well Use

1 LOCATION OF WATER WELL: County: Sedgwick Fraction NW 1/4 SW 1/4 NE 1/4 SW 1/4 Section Number 16 Township Number T 26 S Range Number R 1 E W

2 WELL OWNER: Last Name: Rathje First: Ryan Street or Rural Address where well is located (if unknown, distance and direction from nearest town or intersection): If at owner's address, check here: X

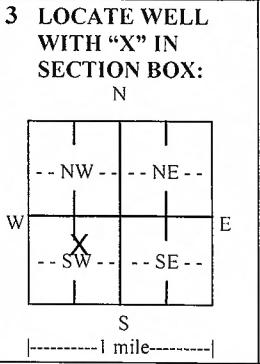

3 LOCATE WELL WITH 'X' IN SECTION BOX: N W E S 1 mile

4 DEPTH OF COMPLETED WELL: 140 ft. Depth(s) Groundwater Encountered: 1) 12 ft. 2) ft. 3) ft. or 4) Dry Well WELL'S STATIC WATER LEVEL: 12 ft. below land surface, measured on (mo-day-yr) 11/1/2018

5 Latitude: 37.78584 Longitude: 97.43979 Datum: X WGS 84 Source for Latitude/Longitude: GPS (unit make/model) Land Survey Topographic Map Online Mapper

7 WELL WATER TO BE USED AS: 1. Domestic: X Lawn & Garden 2. Irrigation 3. Feedlot 4. Industrial 5. Public Water Supply 6. Dewatering 7. Aquifer Recharge 8. Monitoring 9. Environmental Remediation 10. Oil Field Water Supply 11. Test Hole 12. Geothermal 13. Other

Was a chemical/bacteriological sample submitted to KDHE? X No If yes, date sample was submitted: Water well disinfected? X Yes

8 TYPE OF CASING USED: X PVC CASING JOINTS: X Glued Casing diameter 5 in. to 140 ft. Diameter 18 in. Weight lbs./ft. Wall thickness or gauge No. 0.214

TYPE OF SCREEN OR PERFORATION MATERIAL: X PVC SCREEN OR PERFORATION OPENINGS ARE: X Mill Slot SCREEN-PERFORATED INTERVALS: From 120 ft. to 140 ft. GRAVEL PACK INTERVALS: From 23 ft. to 140 ft.

9 GROUT MATERIAL: X Bentonite Nearest source of possible contamination: X Watertight Sewer Lines Direction from well? Northwest South Distance from well? 100 ft.

Table with 6 columns: 10 FROM, TO, LITHOLOGIC LOG, FROM, TO, LITHO. LOG (cont.) or PLUGGING INTERVALS. Rows include Sandy Topsoil, Topsoil, Brown Clay, Fine Sand, Fine/Some Medium Sand, Medium Sand, Brown Clay, Fine/Medium Sand.

11 CONTRACTOR'S OR LANDOWNER'S CERTIFICATION: This water well was X constructed, reconstructed, or plugged under my jurisdiction and was completed on (mo-day-year) 11/1/2018. Kansas Water Well Contractor's License No. 238 This Water Well Record was completed on (mo-day-year) 11/2/2018 under the business name of Premier Pump and Well Service, Inc.

Notes: Well is NOT @ risk of contamination