

CORRECTIVE - EXTRA GROUT

WATER WELL RECORD Form WWC-5


Division of Water Resources App. No.

Well ID

Original Record Correction Change in Well Use

1 LOCATION OF WATER WELL: County: Sedgwick Fraction NE 1/4 NW 1/4 SE 1/4 NE 1/4 Section Number 27 Township Number T 26 S Range Number R 1 E W

2 WELL OWNER: Last Name: Business: Beverlin, LLC Address: PO Box 56 City: Ebing State: Kansas ZIP: 67041 Street or Rural Address where well is located: 4309 N Sunny Lane Wichita, KS 67205

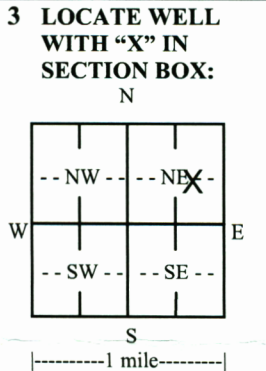

3 LOCATE WELL WITH 'X' IN SECTION BOX: 4 DEPTH OF COMPLETED WELL: 78 ft. Depth(s) Groundwater Encountered: 1) 16 ft. 2) 3) 4) Dry Well WELL'S STATIC WATER LEVEL: 16 ft. below land surface, measured on (mo-day-yr) 2/7/2022

5 Latitude: 37.762310 Longitude: -97.410790 Datum: WGS 84 GPS (unit make/model): Land Survey Topographic Map Online Mapper:

6 Elevation: Ground Level TOC Source: Land Survey GPS Topographic Map Other

7 WELL WATER TO BE USED AS: 1. Domestic: Household Lawn & Garden Livestock Irrigation Feedlot Industrial 2. Public Water Supply: well ID 3. Dewatering: how many wells? 4. Aquifer Recharge: well ID 5. Monitoring: well ID 6. Environmental Remediation: well ID Air Sparge Soil Vapor Extraction Recovery Injection 7. Oil Field Water Supply: lease 8. Test Hole: well ID Cased Uncased Geotechnical 9. Geothermal: how many bores? a) Closed Loop Horizontal Vertical b) Open Loop Surface Discharge Inj. of Water 10. Other (specify):

Was a chemical/bacteriological sample submitted to KDHE? Yes No If yes, date sample was submitted: Water well disinfected? Yes No

8 TYPE OF CASING USED: Steel PVC Other CASING JOINTS: Glued Clamped Welded Threaded Casing diameter 5 in. to 78 ft. Diameter in. to ft. Diameter in. to ft. Casing height above land surface 18 in. Weight lbs./ft. Wall thickness or gauge No. 0.214

TYPE OF SCREEN OR PERFORATION MATERIAL: Steel Stainless Steel PVC Other (Specify) Brass Galvanized Steel None used (open hole)

SCREEN OR PERFORATION OPENINGS ARE: Continuous Slot Mill Slot Gauze Wrapped Torch Cut Drilled Holes Other (Specify) Louvered Shutter Key Punched Wire Wrapped Saw Cut None (Open Hole)

SCREEN-PERFORATED INTERVALS: From 58 ft. to 78 ft. From ft. to ft. From ft. to ft. GRAVEL PACK INTERVALS: From 21 ft. to 78 ft. From 59 ft. to 60 ft. From ft. to ft.

9 GROUT MATERIAL: Neat cement Cement grout Bentonite Other 0-1 compacted topsoil Grout Intervals: From 1 ft. to 21 ft. From ft. to ft. From ft. to ft.

Nearest source of possible contamination: No potential source of contamination within 200 ft. Septic Tank Lateral Lines Pit Privy Livestock Pens Insecticide Storage Sewer Lines Cess Pool Sewage Lagoon Fuel Storage Abandoned Water Well Watertight Sewer Lines Seepage Pit Feedyard Fertilizer Storage Oil Well/Gas Well Other (Specify) Direction from well? West Distance from well? 22 ft.

Table with columns: FROM, TO, LITHOLOGIC LOG, FROM, TO, LITHO. LOG (cont.) or PLUGGING INTERVALS. Rows: 0-3 Topsoil, 3-6 Brown Clay, 6-22 Fine Sand, 22-51 Medium Sand/Coarse Gravel, 51-56 Medium Sand w Green Clay Layers, 56-78 Fine White Sand

Notes:

11 CONTRACTOR'S OR LANDOWNER'S CERTIFICATION: This water well was constructed, reconstructed, or plugged under my jurisdiction and was completed on (mo-day-year) 2/7/2022 and this record is true to the best of my knowledge and belief. Kansas Water Well Contractor's License No. 238 This Water Well Record was completed on (mo-day-year) 2/9/2022 under the business name of Premier Pump & Well Service, Inc. #238