

1 LOCATION OF WATER WELL: Fraction NW 1/4 SW 1/4 NE 1/4 Section Number 19 Township Number T 26 S Range Number R 1 EW
County: SEDGWICK
Distance and direction from nearest town or city street address of well if located within city?


111 K HEDGVE - MARRE, KS.

2 WATER WELL OWNER: DENNIS SUMNER
RR#, St. Address, Box #: 111 K HEDGVE
City, State, ZIP Code: MARRE, KS. 67101

Board of Agriculture, Division of Water Resources

Application Number:

3 LOCATE WELL'S LOCATION WITH AN "X" IN SECTION BOX:

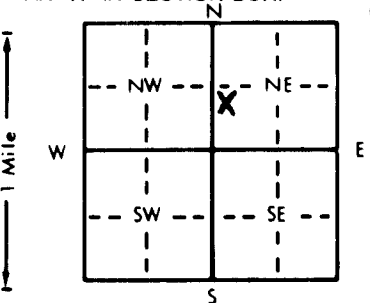

4 DEPTH OF COMPLETED WELL: 48 ft. ELEVATION:

Depth(s) Groundwater Encountered 1. 22 ft. 2. ft. 3. ft.

WELL'S STATIC WATER LEVEL: 22 ft. below land surface measured on mo/day/yr 9-1-87

Pump test data: Well water was 22 ft. after 12 hours pumping 20 gpm

Est. Yield 80 gpm Well water was ft. after hours pumping gpm

Bore Hole Diameter 11 in. to 48 ft. and in. to ft.

WELL WATER TO BE USED AS:

1 Domestic 3 Feedlot 6 Oil field water supply 9 Dewatering 12 Other (Specify below)

2 Irrigation 4 Industrial 7 Lawn and garden only 10 Observation well

Was a chemical/bacteriological sample submitted to Department? Yes No X; If yes, mo/day/yr sample was submitted

Water Well Disinfected? Yes X No

5 TYPE OF BLANK CASING USED:

1 Steel 3 RMP (SR)

2 PVC 4 ABS

5 Wrought iron

6 Asbestos-Cement

7 Fiberglass

8 Concrete tile

9 Other (specify below)

CASING JOINTS: Glued X Clamped

Welded

Threaded

Blank casing diameter 5 in. to 38 ft. Dia 1.59 in. to ft. Dia in. to ft.

Casing height above land surface 12 in. weight 1.59 lbs./ft. Wall thickness or gauge No. SPR-20

TYPE OF SCREEN OR PERFORATION MATERIAL:

1 Steel 3 Stainless steel

2 Brass 4 Galvanized steel

5 Fiberglass

6 Concrete tile

7 PVC

8 RMP (SR)

9 ABS

10 Asbestos-cement

11 Other (specify)

12 None used (open hole)

SCREEN OR PERFORATION OPENINGS ARE:

1 Continuous slot 3 Mill slot

2 Louvered shutter 4 Key punched

5 Gauzed wrapped

6 Wire wrapped

7 Torch cut

8 Saw cut

9 Drilled holes

10 Other (specify)

11 None (open hole)

SCREEN-PERFORATED INTERVALS: From 38 ft. to 48 ft. From ft. to ft.

From ft. to ft. From ft. to ft.

GRAVEL PACK INTERVALS: From 23 ft. to 48 ft. From ft. to ft.

From ft. to ft. From ft. to ft.

6 GROUT MATERIAL: 1 Neat cement 2 Cement grout 3 Bentonite 4 Other

Grout intervals: From 3 ft. to 23 ft. From ft. to ft. From ft. to ft.

What is the nearest source of possible contamination:

1 Septic tank 4 Lateral lines

2 Sewer lines 5 Cess pool

3 Watertight sewer lines 6 Seepage pit

7 Pit privy

8 Sewage lagoon

9 Feedyard

10 Livestock pens

11 Fuel storage

12 Fertilizer storage

13 Insecticide storage

14 Abandoned water well

15 Oil well/Gas well

16 Other (specify below)

Direction from well?

South

How many feet? 60

FROM	TO	LITHOLOGIC LOG	FROM	TO	LITHOLOGIC LOG
0	2	Top soil			
2	17	clay			
17	32	fine sand			
32	33	clay			
33	78	Sand			

7 CONTRACTOR'S OR LANDOWNER'S CERTIFICATION: This water well was (1) constructed, (2) reconstructed, or (3) plugged under my jurisdiction and was

completed on (mo/day/year) 9-1-87 and this record is true to the best of my knowledge and belief. Kansas

Water Well Contractor's License No. 318 This Water Well Record was completed on (mo/day/yr) 9-10-87

under the business name of WENINGER DRILLING by (signature) Jerome Weninger

INSTRUCTIONS: Use typewriter or ball point pen. PLEASE PRESS FIRMLY and PRINT clearly. Please fill in blanks, underline or circle the correct answers. Send top three copies to Kansas

Department of Health and Environment, Bureau of Water Protection, Topeka, Kansas 66620-7320. Telephone: 913-862-9360. Send one to WATER WELL OWNER and retain one for your

records.