USE TYPEWRITER OR BALL POINT PEN-PRESS FIRMLY, PRINT CLEARLY.

WATER WELL RECORD
KSA 82a-1201-1215

Kansas Department of Health and Environment-Division of Environment
(Water well Contractors)
Topeka, Kansas 66620

1. Location of well:	County	Fraction	Section number	Township number	Range number
	SEDGWICK	SW 1/4 SW SE/4 SE1/4	31	T 26 S	R 1~~4~~ W E/W

2. Distance and direction from nearest town or city: 10720 W, 29th N. Wichita, Ks.
Street address of well location if in city:

3. Owner of well: Dean Bell
R.R. or street: 10720 W. 29th N.
City, state, zip code: Wichita, Ks.

4. Locate with "X" in section below:

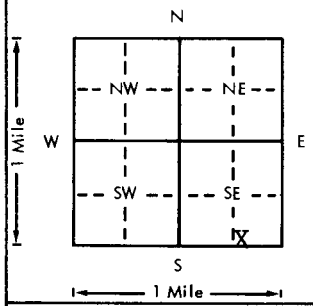

Sketch map:

6. Bore hole dia. 11 in. Completion date
Well depth 60 ft. 4-14-79

7. __ Cable tool X Rotary __ Driven __ Dug
__ Hollow rod __ Jetted __ Bored __ Reverse rotary

8. Use: __ Domestic __ Public supply __ Industry
__ Irrigation __ Air conditioning __ Stock
X Lawn __ Oil field water __ Other

9. Casing: Material Styrene Height: Above or below
Threaded __ Welded gl Surface 12 in.
RMP X PVC __ Weight __ lbs./ft.
Dia. 5 in. to 59 ft. depth Wall Thickness: inches or
Dia. __ in. to __ ft. depth gage No. .200

5. Type and color of material	From	To
Topsoil	0	3
~~Clay~~	3	12
Fine Sand	12	35
Medium Sand	35	39
Clay	39	43
Medium Sand	43	60
(Use a second sheet if needed)		

10. Screen: Manufacturer's name Sunflower Plastic
Type Styrene Dia. 5"
Slot/~~gauze~~ 06 Length 15'
Set between 45 ft. and 60 ft.
ft. and ft.
Gravel pack? yes Size range of material 1/8-1/8"

11. Static water level: mo./day/yr.
15 ft. below land surface Date 4-14-79

12. Pumping level below land surfaces:
ft. after hrs. pumping g.p.m.
ft. after hrs. pumping g.p.m.
Estimated maximum yield g.p.m.

13. X Water sample submitted: mo./day/yr.
__ Yes __ No Date

14. Well head completion: capped
__ Pitless adapter 12 Inches above grade

15. Well grouted? yes 1-2 Fine Sand Mix
With: __ Neat cement __ Bentonite X Concrete
Depth: From 40" ft. to 14' ft.

16. Nearest source of possible contamination:
ft. 60 Direction East Type Lagoon
Well disinfected upon completion? X Yes __ No

17. Pump: X Not installed
Manufacturer's name
Model number HP Volts
Length of drop pipe ft. capacity g.p.m.
Type:
__ Submersible __ Turbine
__ Jet __ Reciprocating
__ Centrifugal __ Other

18. Elevation:

Topography:
__ Hill
__ Slope
__ Upland
__ Valley

19. Remarks: Flat Ground

20. Water well contractor's certification:
This well was drilled under my jurisdiction and this report is true to the best of my knowledge and belief.
Harp Well & Pump 236
Business name License No.
Address Wichita, Ks.
Signed M. Arnold Date 5-12-79
Authorized representative

T 26 R 1~~4~~ W E Sec 31 1/4 1/4 1/4 SESE

Forward the white, blue and pink copies to the Department of Health and Environment

Form WWC-5

MI-1023