USE TYPEWRITER OR BALL POINT PEN-PRESS FIRMLY, PRINT CLEARLY.

WATER WELL RECORD
KSA 82a-1201-1215

Kansas Department of Health and Environment-Division of Environment
(Water well Contractors)
Topeka, Kansas 66620

| 1. Locotion of well: | County | Fraction | Section number | Township number | Range number |
|---|---|---|---|---|---|
| | Sedgwick | 1/4 SE 1/4 SE 1/4 | 1 | T 26 S | R 1W E/W |

2. Distance and direction from nearest town or city:
Street address of well location if in city: #2 Chaparral Wichita, Kansas

3. Owner of well: Dean Frankenberry Construction
R.R. or street: 1600 W. 61st North
City, state, zip code: Wichita, Kansas

4. Locote with "X" in section below:

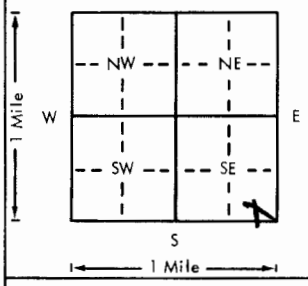


Sketch map: (69th North and Meridian, then north.)

6. Bore hole dia. 11 in. Completion date
Well depth 35 ft. 12-28-78

7. __ Cable tool X Rotary __ Driven __ Dug
__ Hollow rod __ Jetted __ Bored __ Reverse rotary

8. Use: X Domestic __ Public supply __ Industry
__ Irrigation __ Air conditioning __ Stock
__ Lawn __ Oil field water __ Other

9. Casing: Material Styrene Height: Above or Below
Threaded ___ Welded gl Surface 12 in.
RMP X PVC ___ Weight ___ lbs./ft.
Dia. 5 in. to 35 ft. depth Wall Thickness: inches or
Dia. ___ in. to ___ ft. depth gage No. .200

| 5. Type and color of material | From | To |
|---|---|---|
| Sandy soil | 0 | 2 |
| Sandy clay | 2 | 8 |
| Fine to Medium sand | 8 | 15 |
| Medium to Coarse sand and gravel | 15 | 35 |
| | | |
| | | |
| | | |
| | | |
| | | |
| | | |
| | | |
| | | |
| | | |
| | | |
| (Use a second sheet if needed) | | |

10. Screen: Manufacturer's name Sunflower plastic
Type styrene Dia. 5"
Slot/~~gauze~~ .06 Length 10'
Set between 25 ft. and 35 ft.
___ ft. and ___ ft.
Gravel pack? yes Size range of material 1/4-1/8"

11. Static water level: mo./day/yr.
15 ft. below land surface Date 12-28-78

12. Pumping level below lond surfaces:
___ ft. after ___ hrs. pumping ___ g.p.m.
___ ft. after ___ hrs. pumping ___ g.p.m.
Estimated maximum yield ___ g.p.m.

13. Water sample submitted: mo./day/yr.
___ Yes ___ No Date ___

14. Well head completion: capped
___ Pitless adapter 12 Inches above grade

15. Well grouted? yes 1-2fine sand mix
With: ___ Neat cement ___ Bentonite X Concrete
Depth: From 6 ft. to 16 ft.

16. Nearest source of possible contamination:
ft. ___ Direction ___ Type None
Well disinfected upon completion? X Yes ___ No

17. Pump: X Not installed
Manufacturer's name ___
Model number ___ HP ___ Volts ___
Length of drop pipe ___ ft. capacity ___ g.p.m.
Type:
___ Submersible ___ Turbine
___ Jet ___ Reciprocating
___ Centrifugal ___ Other

18. Elevation:
Topography:
___ Hill
___ Slope
___ Upland
___ Valley

19. Remarks:
Flat ground
Well is to be in the basement.
Septic system not installed at this time.
No apparent source for contamination.

20. Water well contractor's certification:
This well was drilled under my jurisdiction and this report is true to the best of my knowledge and belief.
Harp Well & Pump 236
Business name License No.
Address Wichita, Kansas 67209
Signed M. Arnold Date 1-15-79
(Authorized representative)

T 26 R 1W Sec 1 1/4 1/4 1/4

Forward the white, blue and pink copies to the Department of Health and Environment

Form WWC-5

MI-1023