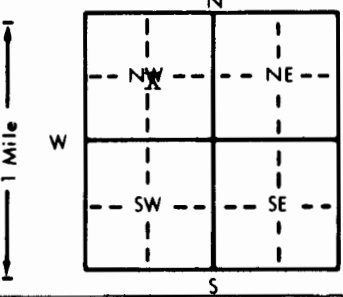


1 LOCATION OF WATER WELL:		Fraction	Approx. Center of	Section Number	Township Number	Range Number
County: Sedgwick		1/4	1/4 NW 1/4	13	T 26 S	R 1 E/W
Distance and direction from nearest town or city street address of well if located within city? 2 miles North of Wichita, KS						
2 WATER WELL OWNER: John Leeker						
RR#, St. Address, Box # : 3772 Jeanette				Board of Agriculture, Division of Water Resources		
City, State, ZIP Code : Wichita, KS 67204				Application Number: not available		
3 LOCATE WELL'S LOCATION WITH AN "X" IN SECTION BOX:		4 DEPTH OF COMPLETED WELL, 60 ft. ELEVATION: unknown				
		Depth(s) Groundwater Encountered 1. 12 ft. 2. ft. 3. ft. WELL'S STATIC WATER LEVEL 12 ft. below land surface measured on mo/day/yr 6/9/81 Pump test data: Well water was not ck'd ft. after hours pumping gpm Est. Yield 800 gpm: Well water was ft. after hours pumping gpm Bore Hole Diameter 24 in. to 60 ft. and in. to ft. WELL WATER TO BE USED AS: 5 Public water supply 8 Air conditioning 11 Injection well 1 Domestic 3 Feedlot 6 Oil field water supply 9 Dewatering 12 Other (Specify below) 2 Irrigation 4 Industrial 7 Lawn and garden only 10 Observation well Was a chemical/bacteriological sample submitted to Department? Yes No X; If yes, mo/day/yr sample was submitted Water Well Disinfected? Yes No X				
5 TYPE OF BLANK CASING USED: 5 Wrought iron 8 Concrete tile CASING JOINTS: Glued Clamped 1 Steel 3 RMP (SR) 6 Asbestos-Cement 9 Other (specify below) Welded XXX 2 PVC 4 ABS 7 Fiberglass Threaded Blank casing diameter 16 in. to 20 ft., Dia. in. to ft., Dia. in. to ft. Casing height above land surface 12 in., weight 31.75 lbs./ft. Wall thickness or gauge No. 188 TYPE OF SCREEN OR PERFORATION MATERIAL: 7 PVC 10 Asbestos-cement 1 Steel 3 Stainless steel 5 Fiberglass 8 RMP (SR) 11 Other (specify) 2 Brass 4 Galvanized steel 6 Concrete tile 9 ABS 12 None used (open hole) SCREEN OR PERFORATION OPENINGS ARE: 5 Gauzed wrapped 8 Saw cut 11 None (open hole) 1 Continuous slot 3 Mill slot 6 Wire wrapped 9 Drilled holes 2 Louvered shutter 4 Key punched 7 Torch cut 10 Other (specify) Doerr Bridge Slot SCREEN-PERFORATED INTERVALS: From 20 ft. to 60 ft., From ft. to ft. GRAVEL PACK INTERVALS: From 10 ft. to 60 ft., From ft. to ft. From ft. to ft., From ft. to ft.						
6 GROUT MATERIAL: 1 Neat cement 2 Cement grout 3 Bentonite 4 Other Grout intervals: From 0 ft. to 10 ft., From ft. to ft., From ft. to ft. What is the nearest source of possible contamination: 10 Livestock pens 14 Abandoned water well 1 Septic tank 4 Lateral lines 7 Pit privy 11 Fuel storage 15 Oil well/Gas well 2 Sewer lines 5 Cess pool 8 Sewage lagoon 12 Fertilizer storage 16 Other (specify below) 3 Watertight sewer lines 6 Seepage pit 9 Feedyard 13 Insecticide storage FIELD Direction from well? How many feet?						
FROM	TO	LITHOLOGIC LOG		FROM	TO	LITHOLOGIC LOG
0	6	Topsoil & brown clay				
6	22	Med. sand & gravel, some coarse				
22	26	Fine-med. sand & gravel				
26	28	MEd. sand & gravel				
28	32	Fine sand & gravel				
32	35	Fine & Medium sand & gravel				
35	42	Fine & Medium sand & gravel				
42	51	Med. sand & gravel, tan clay streak at 47'				
51	52	Green clay, med. coarse sand & gravel				
52	60	Gray shale & clay				
7 CONTRACTOR'S OR LANDOWNER'S CERTIFICATION: This water well was (1) constructed, (2) reconstructed, or (3) plugged under my jurisdiction and was completed on (mo/day/year) 6/9/81 and this record is true to the best of my knowledge and belief. Kansas Water Well Contractor's License No. 185 This Water Well Record was completed on (mo/day/yr) 8/21/81 under the business name of CLARKE WELL & EQUIPMENT INC. by (signature) [Signature]						
INSTRUCTIONS: Use typewriter or ball point pen, PLEASE PRESS FIRMLY and PRINT clearly. Please fill in blanks, underline or circle the correct answers. Send top three copies to Kansas Department of Health and Environment, Division of Environment, Environmental Geology Section, Topeka, KS 66620. Send one to WATER WELL OWNER and retain one for your records.						

OFFICE USE ONLY

T

R

EW

SEC.

13

C 85 11/4

1/4